


COMPUTATION SHEET

Application No. 63918
Permit No. 48690



RECEIVED
JUL 21 1983
WATER RESOURCES
SALEM, OREGON

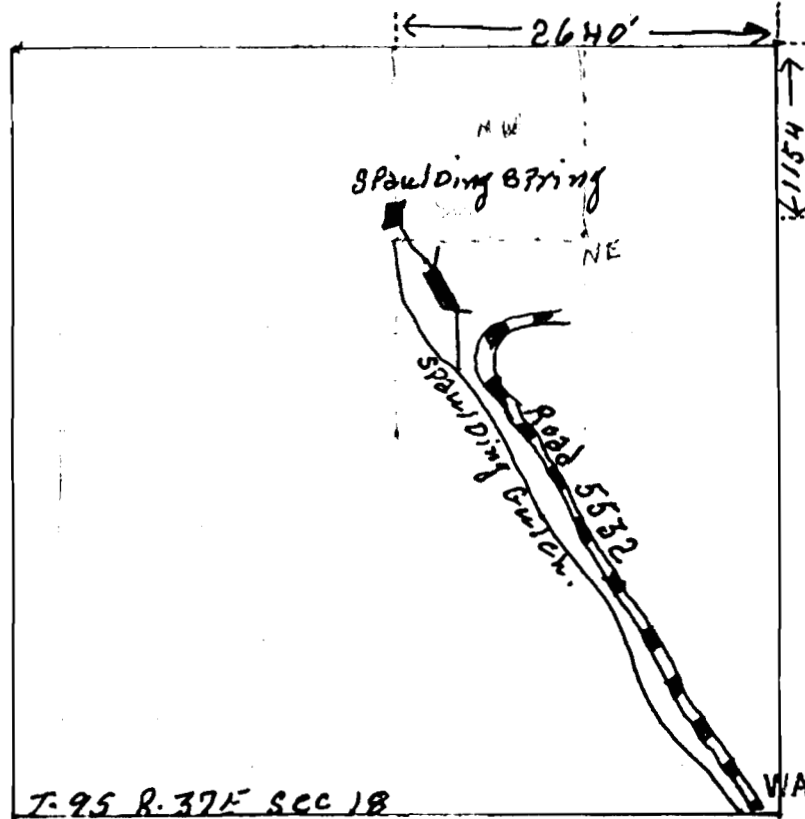

4" = 1 mile

RECEIVED
APR 29 1983
WATER RESOURCES DEPT.
SALEM, OREGON

RECEIVED
MAR 25 1983
WATER RESOURCES DEPT.
SALEM, OREGON

RECEIVED
AUG 23 1982
WATER RESOURCES DEPT.
SALEM, OREGON