

COMPUTATION SHEET

Subject:


Sheet: 001

Date: 10/1/82

Scale: 1" = 1 mile

Project: 63933

Application No. 63933
Permit No. 48705

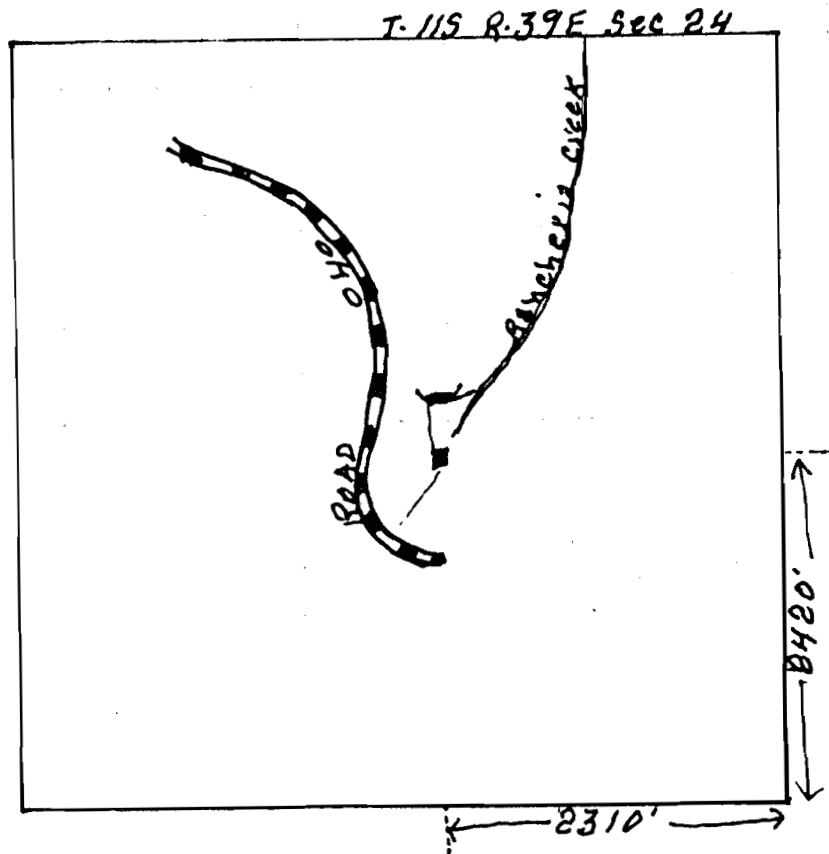

RECEIVED

MAR 25 1983

WATER RESOURCES DEPT.
SALEM, OREGON

RECEIVED

AUG 23 1982

WATER RESOURCES DEPT.
SALEM, OREGON