


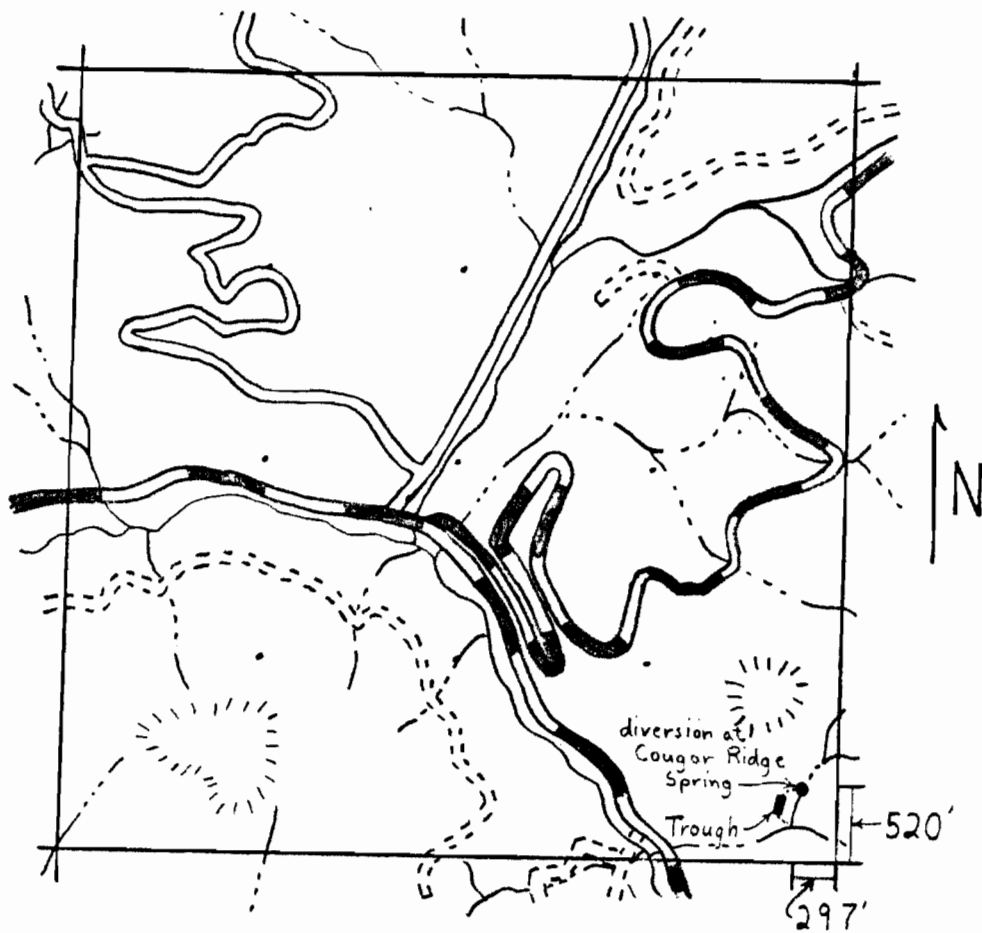

4 inches = 1 mile

T7S R43E Sec10

Application No. 64075

Permit No. 48905