


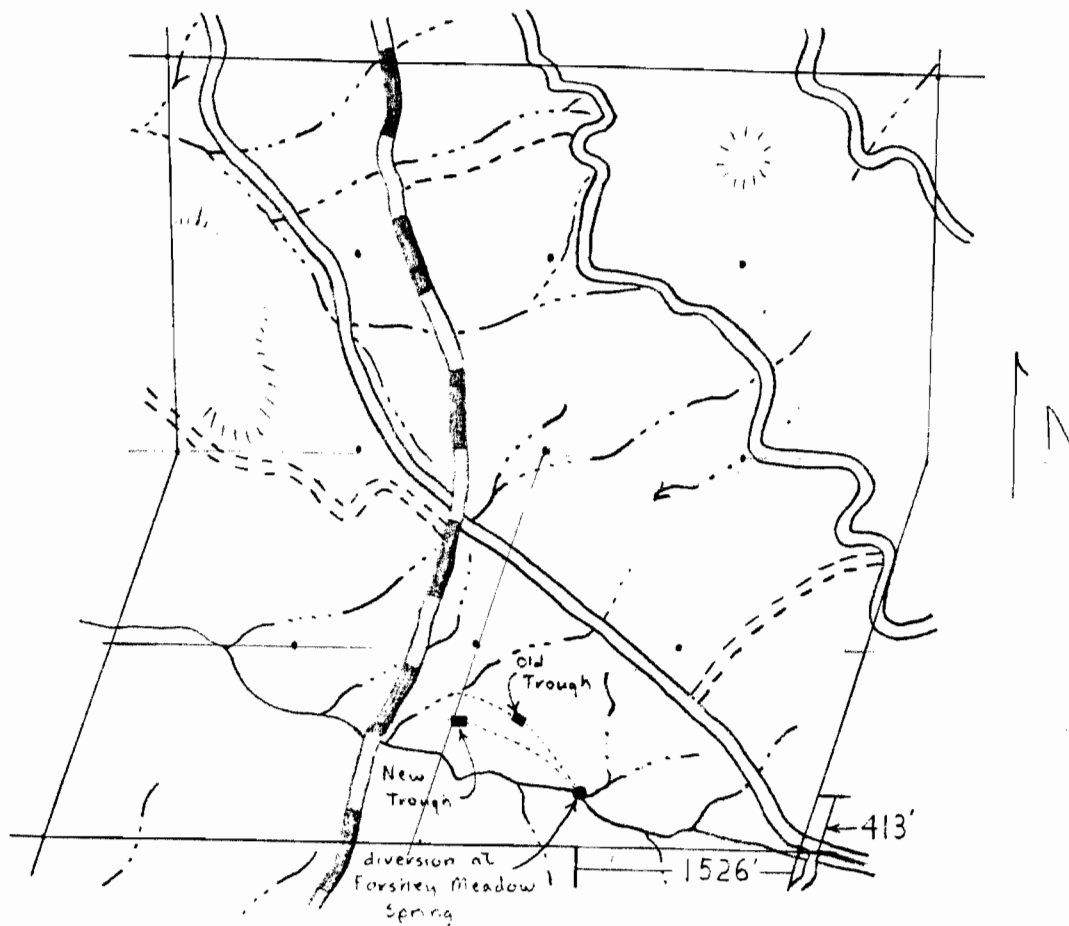

4 inches = 1 mile

T 7 S R 44 E Sec 31

Application No. 64076
 Permit No. 48906