


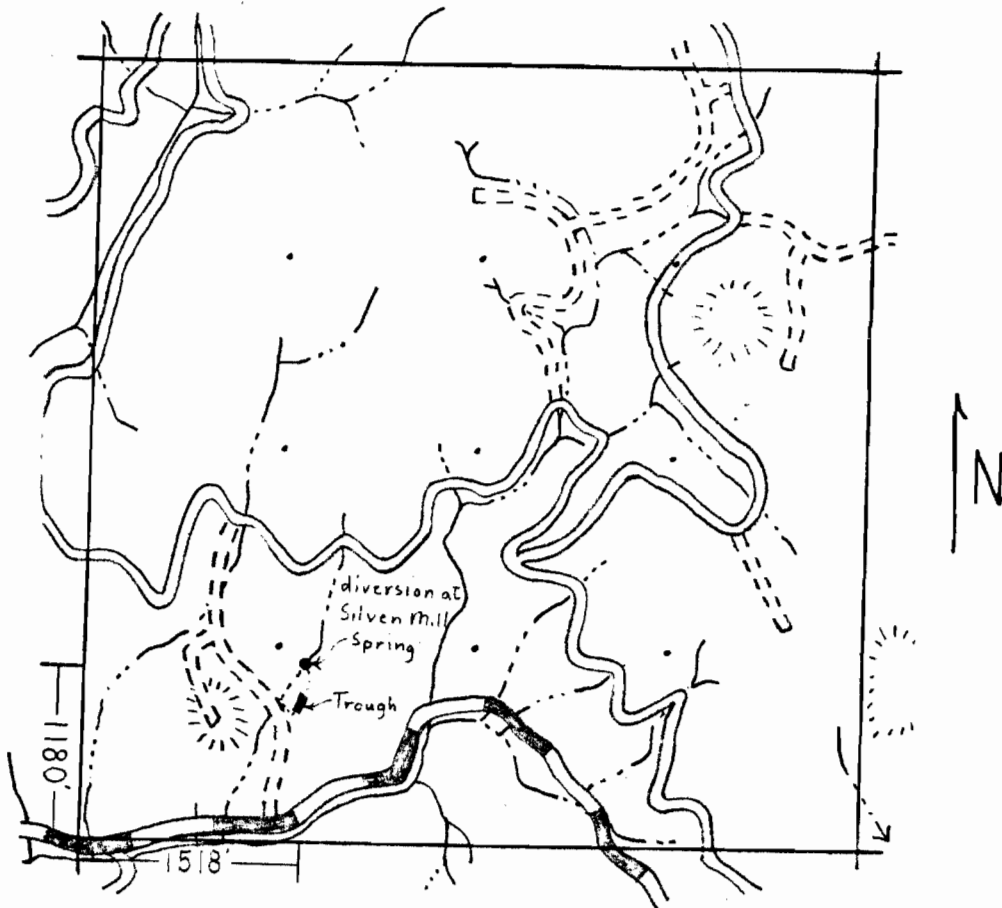

4 inches = 1 mile

T 7 S R 43 E Sec 13

RECEIVED  
DEC 12 1983  
WATER RESOURCES DEPT.  
SALEM, OREGON

Application No. 64077

Permit No. 48907