


Standard Parallel
 Map of Lucas Ditch permit
 Dayville Grant Co Oregon
 Amount of water applied for 1/2 cubic feet
 point of diversion bears from S 1/4 corner of
 Sec 8 Twp 14 S R 27 E
 N 50° 27' E 1462 chains
 Length 36 1/2 miles = 36.50 chains

Certificate of Surveyor
 I Michael Spear of
 Canyon City Grant Co Ore
 do hereby certify this map was made from
 the field during an actual survey
 made by me on Aug 19 1916
 And that it correctly represents the works
 described in the accompanying application
 together with the existing and other
 ditches in the immediate vicinity
 and has been written upon the area
 in 8x14.8 small legal subdivision
 which it is proposed to divide

Michael Spear
 County Surveyor
 Aug 20 1916

Application No. 915
 Permit No. 418

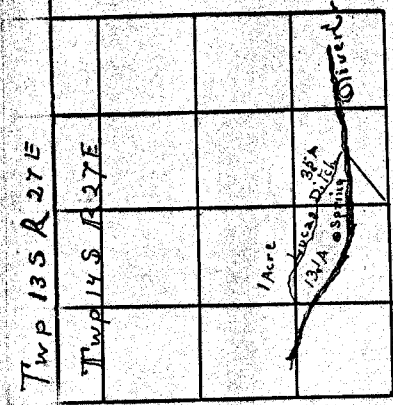

418

418