


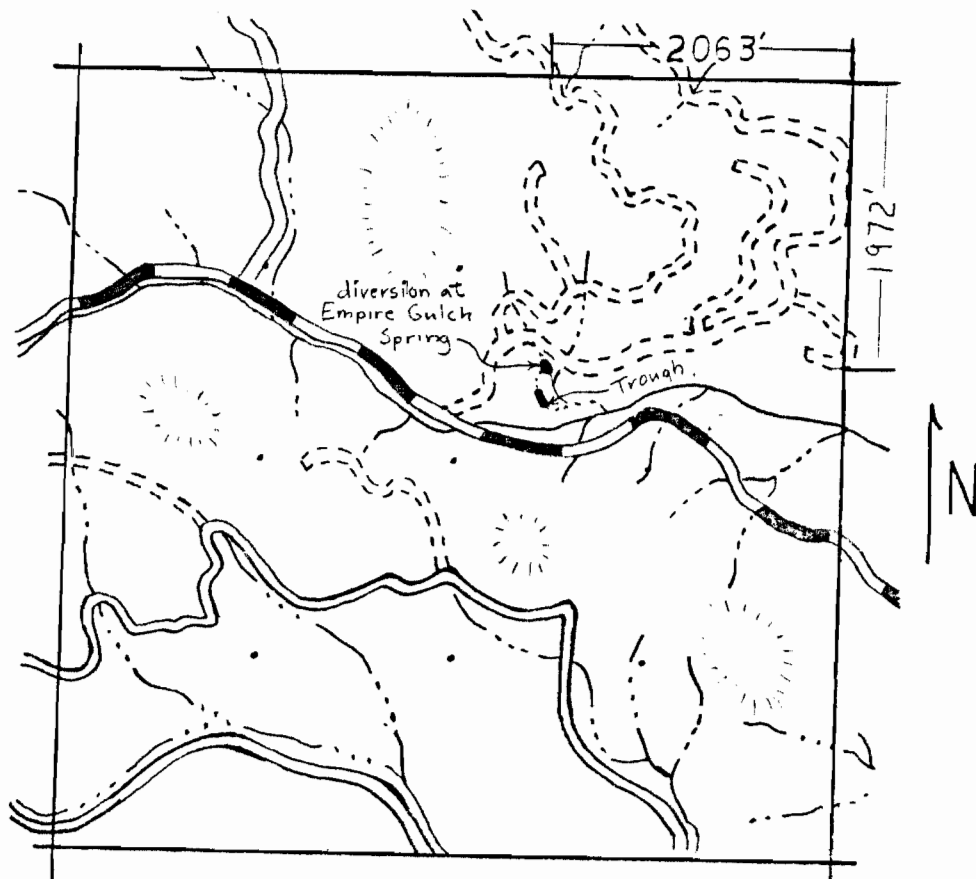

4 inches = 1 mile

T7S R44E Sec20

Application No. 64078

Permit No. 48908