


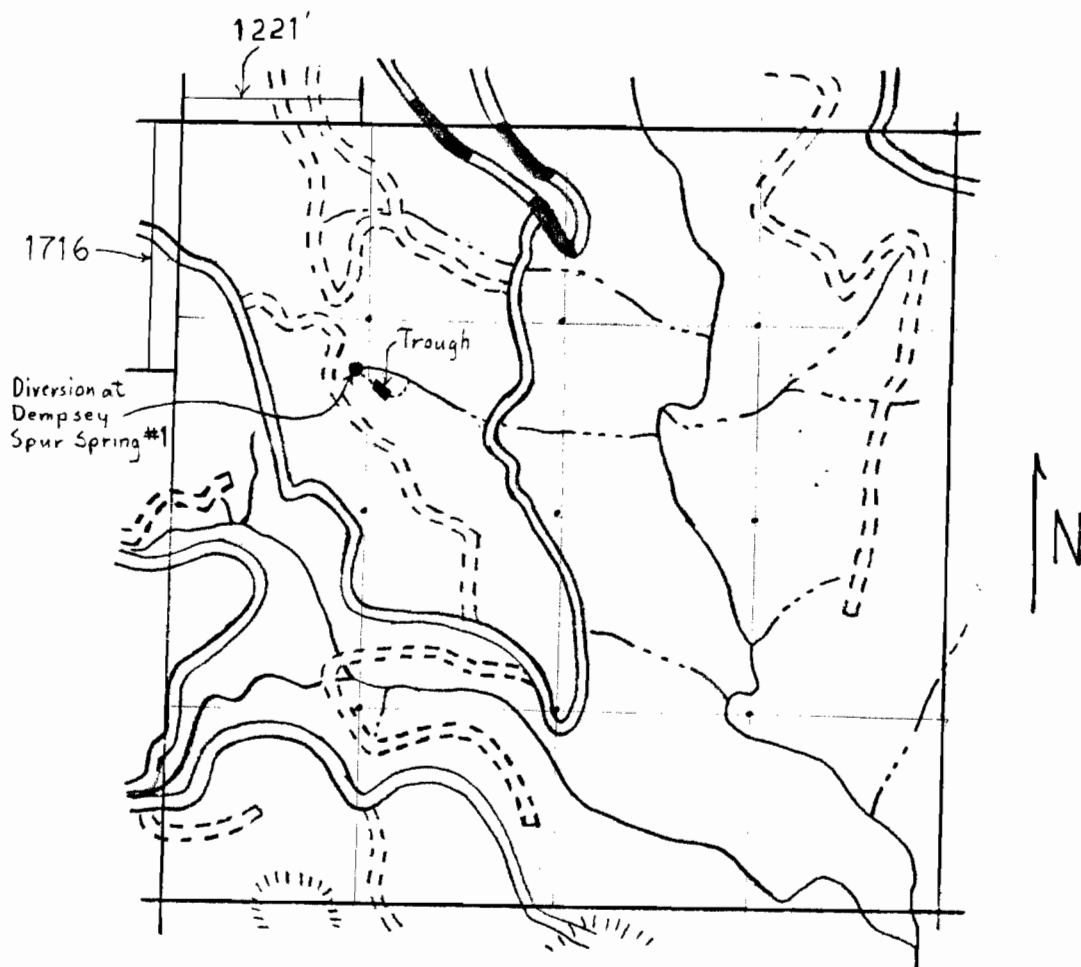

4 inches = 1 mile

T.7S. R44E Sec28

RECEIVED

DEC 12 1983

WATER RESOURCES DEPT.  
SALEM, OREGON

Application No. 64079

Permit No. 48909