


RECEIVED

SEP 8 1983

WATER RESOURCES DEPT.
SALEM, OREGON

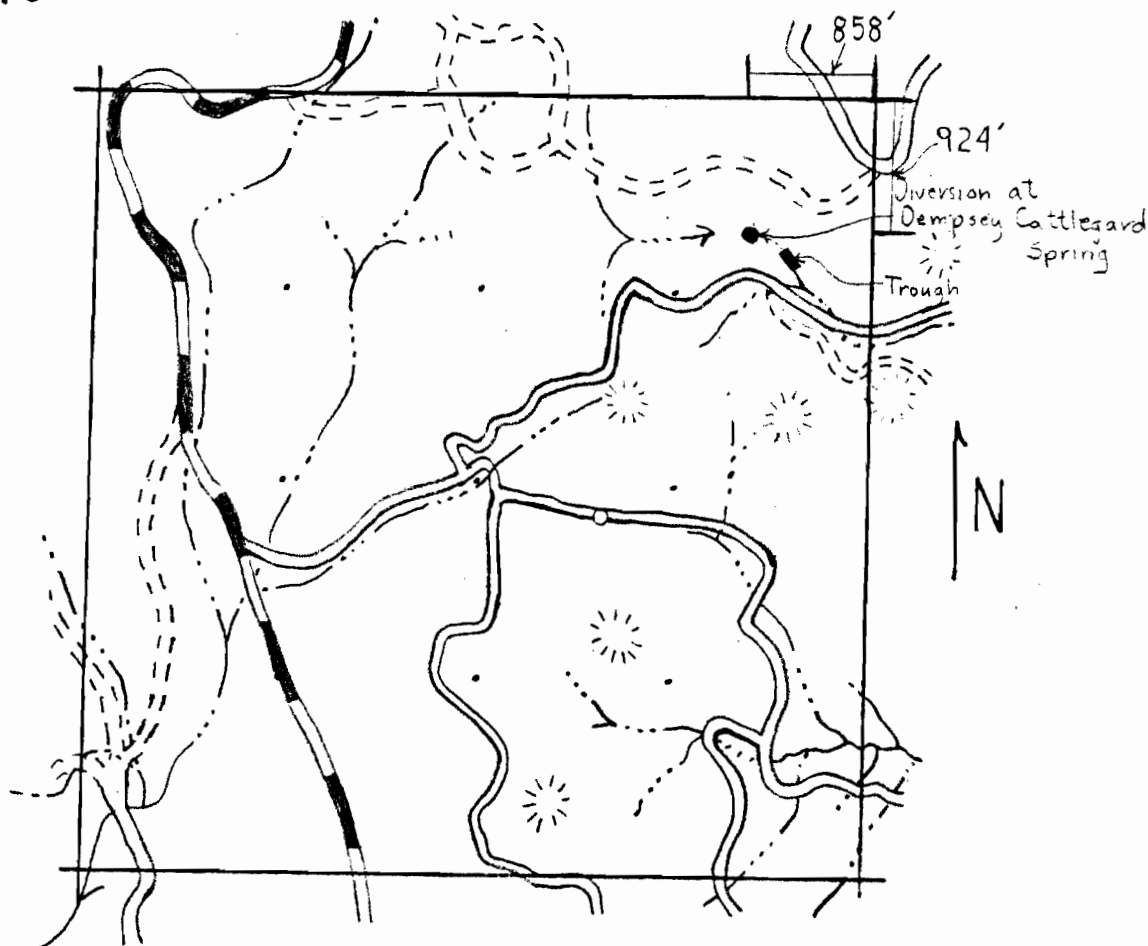

4 inches = 1 mile

T 7 S R 4 E Sec 30

Application No. 64080

Permit No. 48910