


LIVED

SEP 8 1983

**WATER RESOURCES DEPT.
SALEM, OREGON**

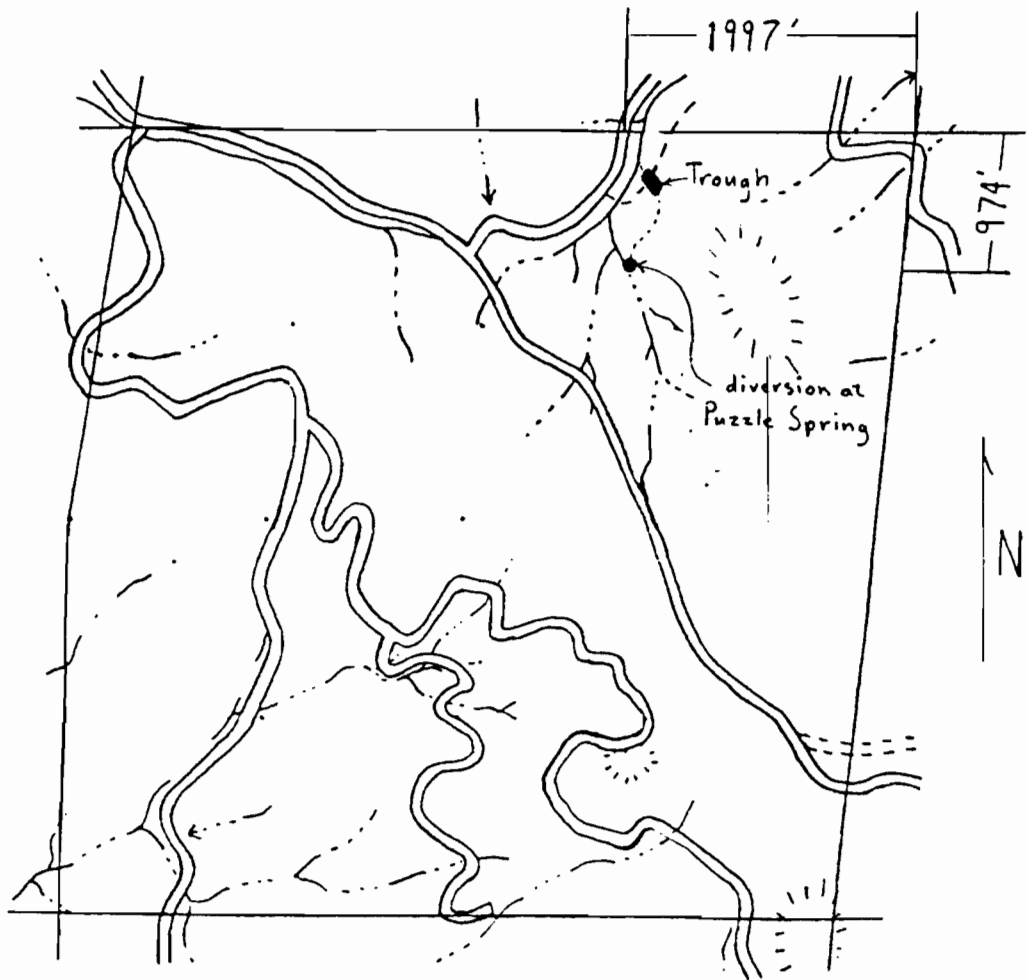

4 inches = 1 mile

T 8 S R 44 E Sec 5

Application No. 64083

Permit No. **48913**