


RECEIVED

SEP 8 1983

**WATER RESOURCES DEPT.
SALEM, OREGON**

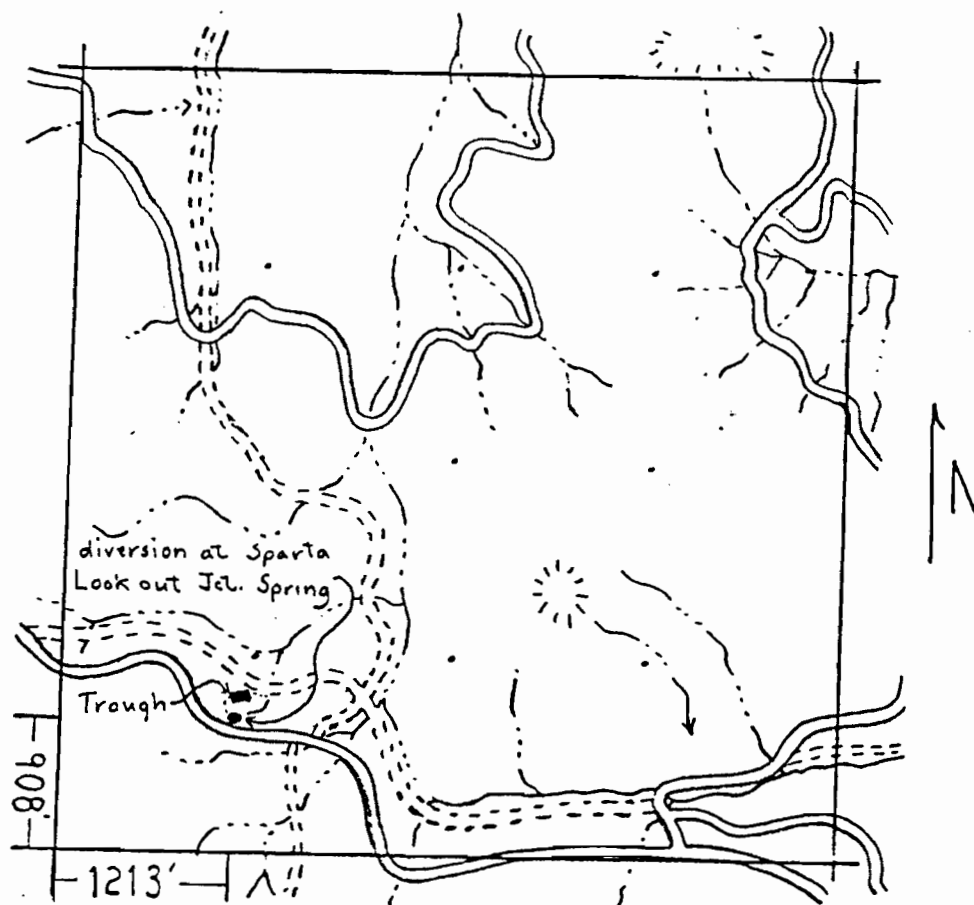

4 inches = 1 mile

T 8 S R 44 E Sec 4

Application No. 64085

Permit No. 48915