


RECEIVED

SEP 8 1983

WATER RESOURCES DEPT.
SALEM, OREGON

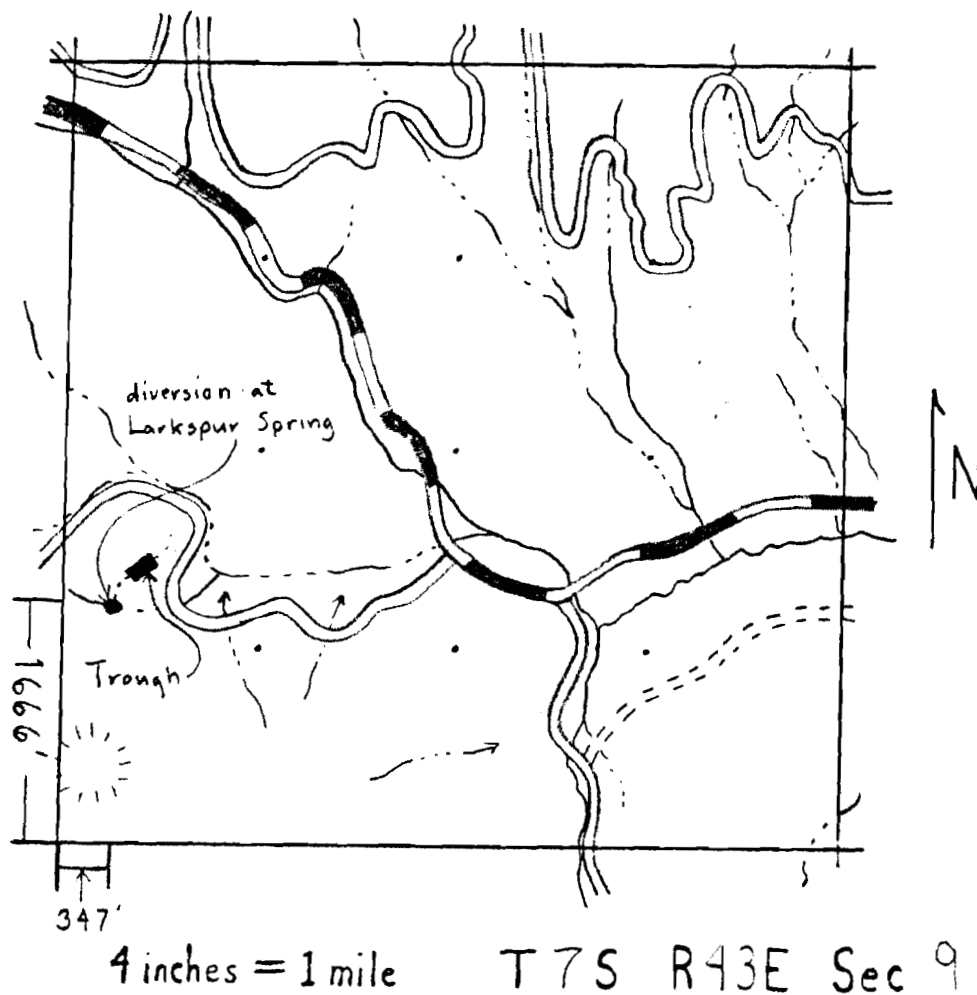

Application No. 64087

Permit No. 48917