


RECEIVED

SEP 8 1983

**WATER RESOURCES DEPT.
SALEM, OREGON**

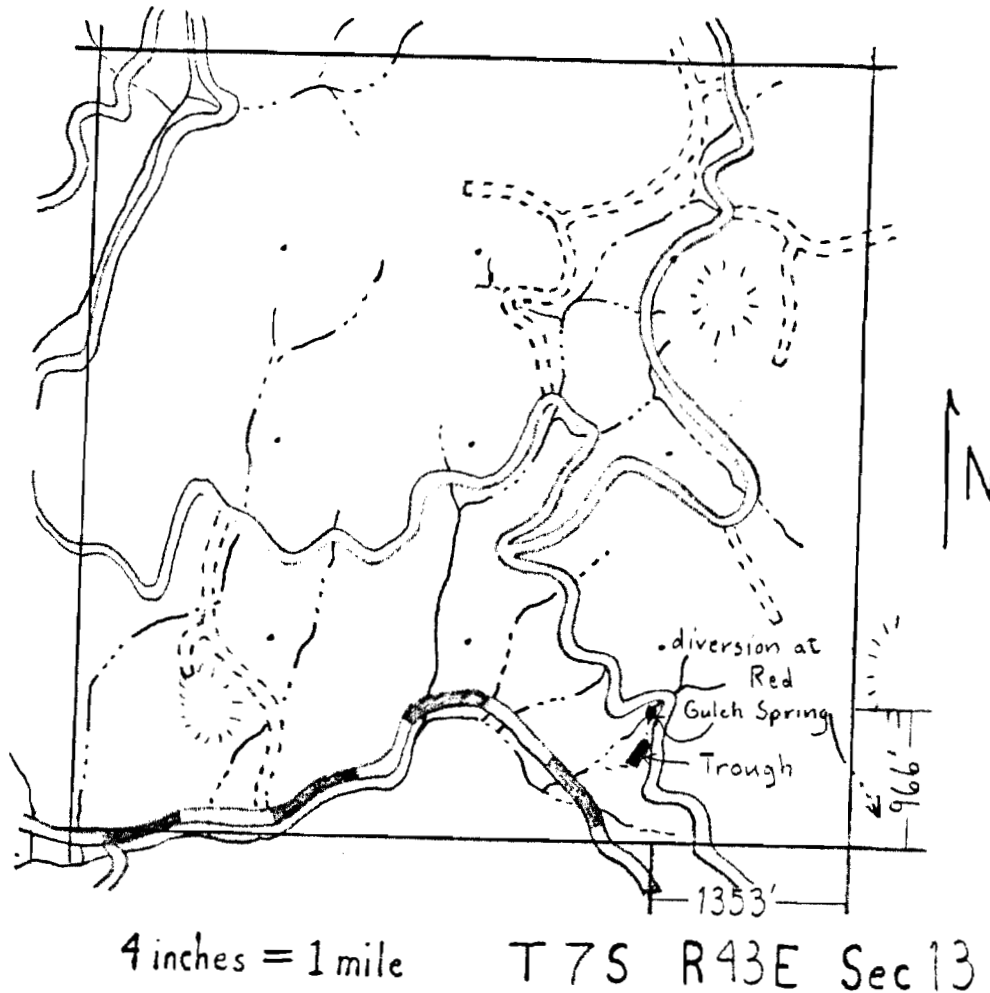

Application No. 64088

Permit No. 48918