RECEIVED
SEP 8 1983
WATER RESOURCES DEPT.
SALEM, OREGON

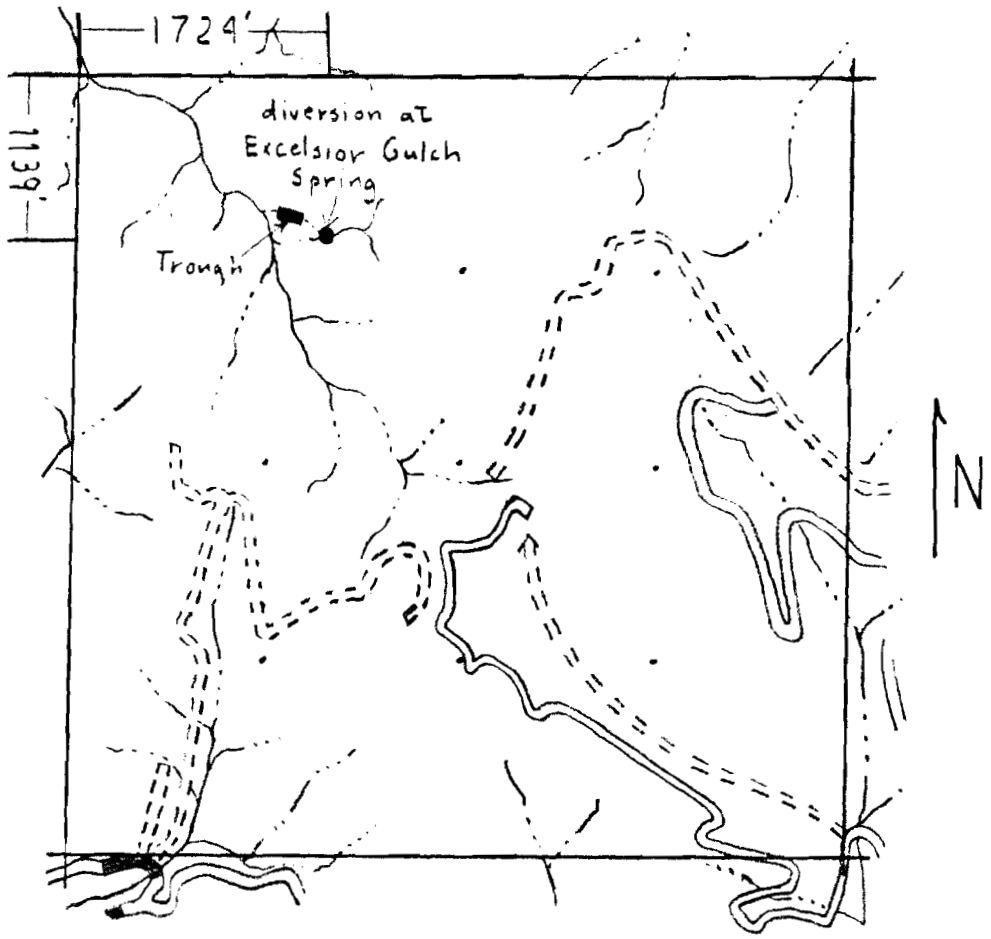

4 inches = 1 mile T 7S R 3E Sec 2

Application No. 64093
Permit No. 48923