


T. 40S., R. 14 & 14 1/2 E., W.M.

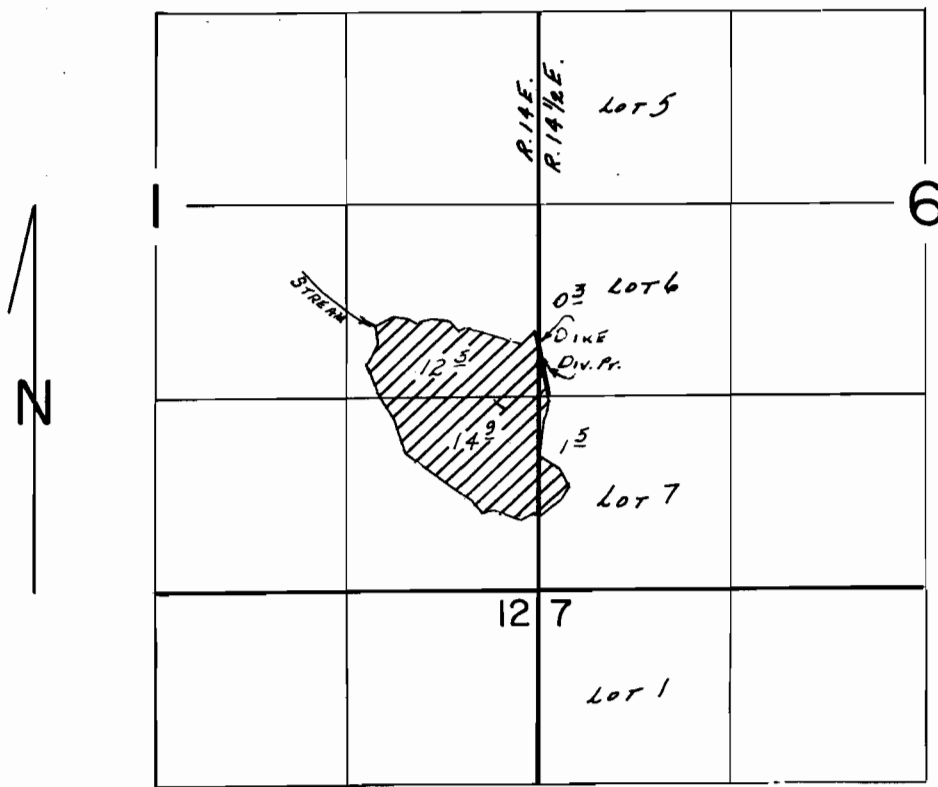

DIV. PT. LOC: 1550' N. & 30' E. FROM SW COR SEC 6.

SCALE: 1"=1320'

FINAL PROOF SURVEY UNDER

Application No. 67676. Permit No. 48888.....
IN NAME OF

BUREAU OF LAND MANAGEMENT

Surveyed AUG 14, 1991, by B.W. BISHOP.....