


RECEIVED

SEP 26 1983

WATER RESOURCES DEPT.

SALEM, OREGON

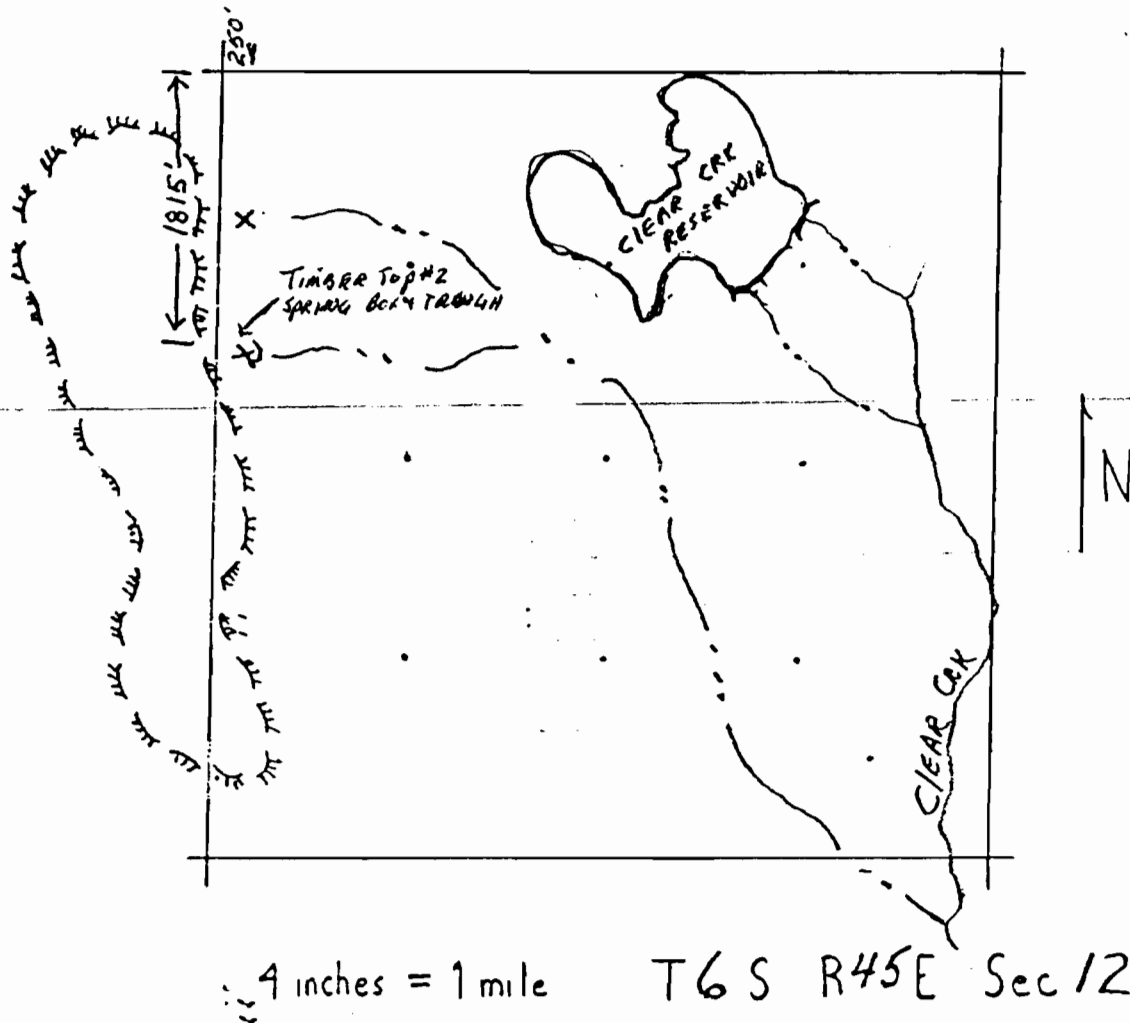

Application No. 66741
Permit No. 50613

USFS # 7-7322