


RECEIVED

SEP 26 1983

WATER RESOURCES DEPT.

SALEM, OREGON

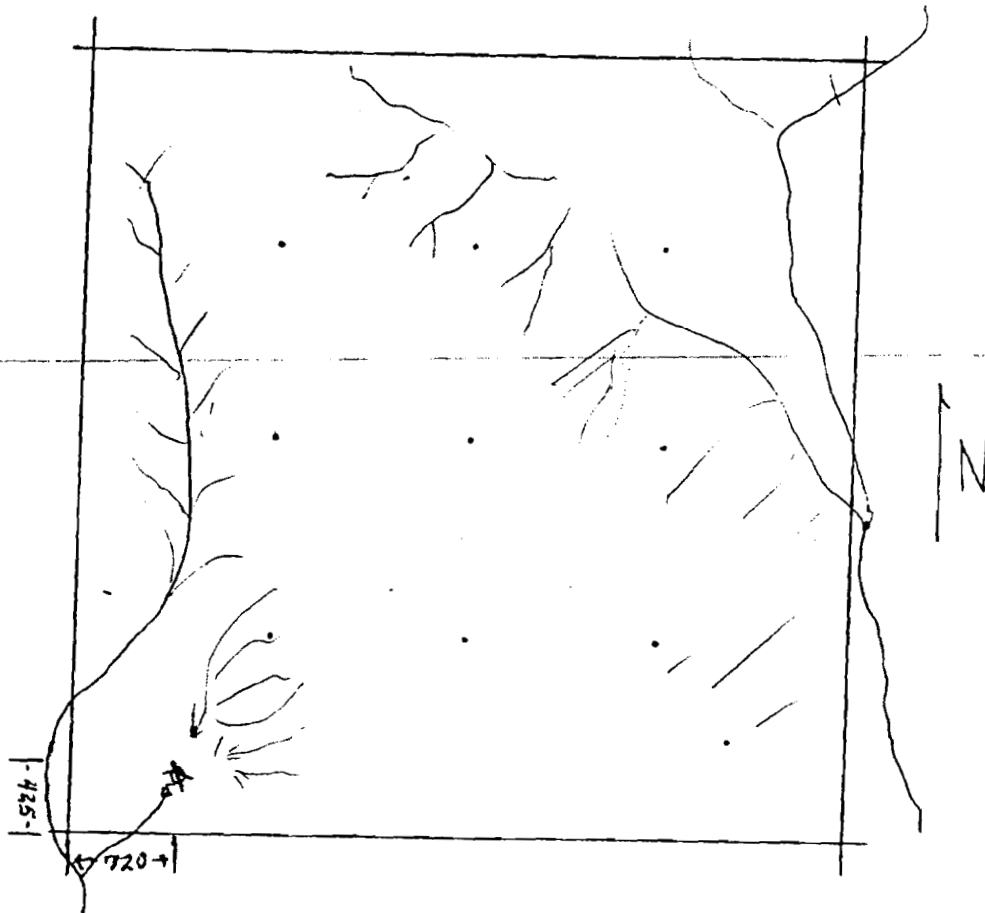

4 inches = 1 mile T6S R45E Sec 13

Application No. 66742
Permit No. 50614

WACRS # 7-7379