


RECEIVED

SEP 26 1983
WATER RESOURCES DEPT.
SALEM, OREGON

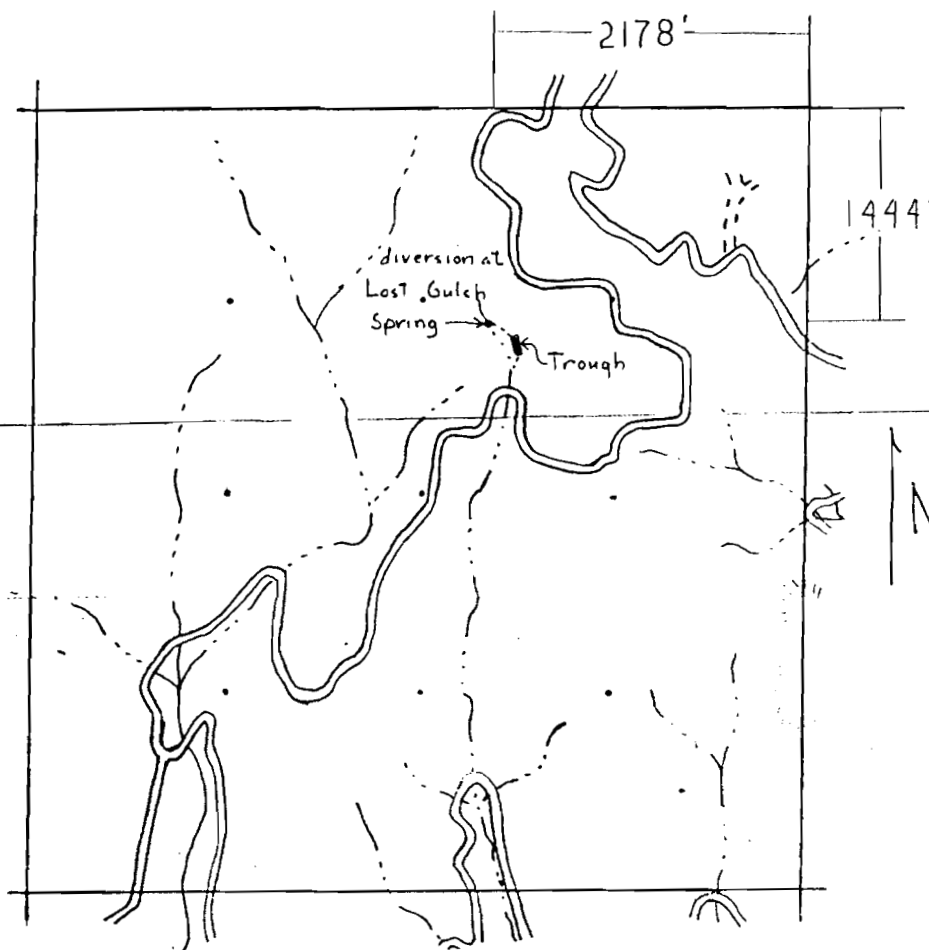

4 inches = 1 mile

T 7 S R 43 E Sec 4

Application No. 66744
Permit No. 50615

USFS# 7-7369