


RECEIVED

SEP 26 1983

WATER RESOURCES DEPT.
SALEM, OREGON

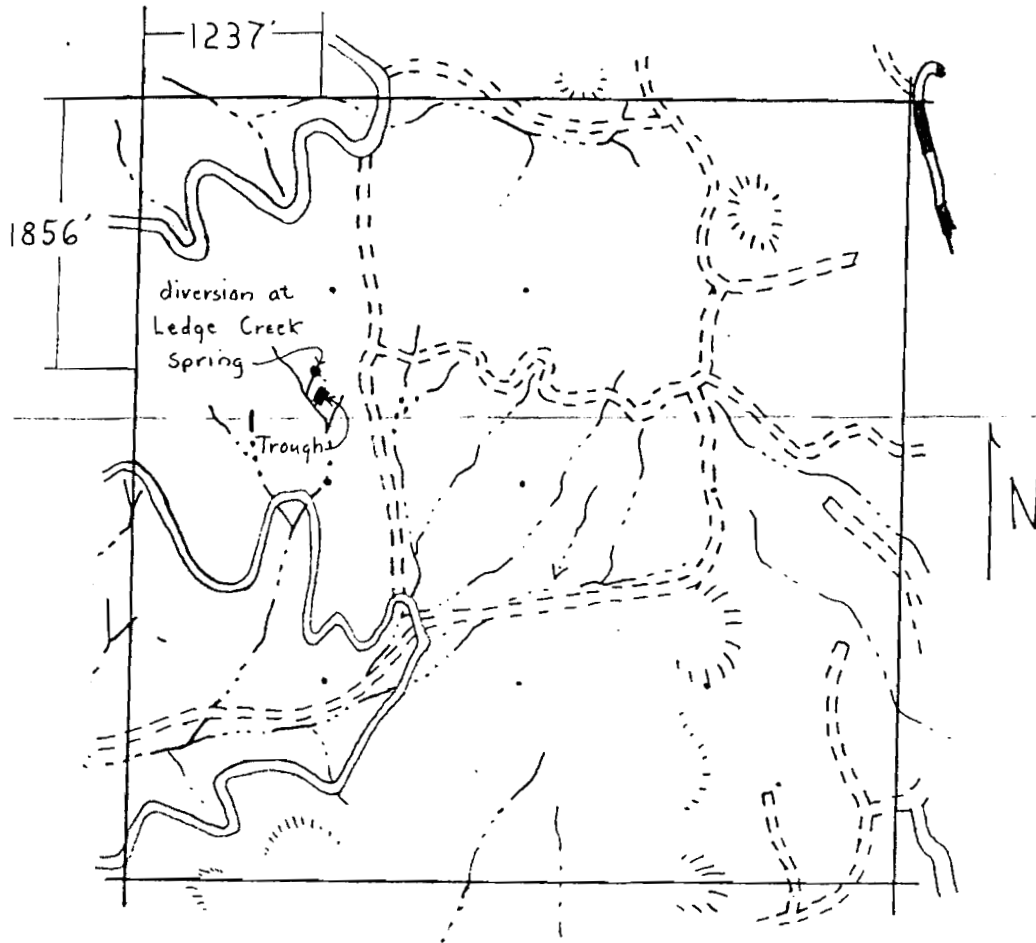

4 inches = 1 mile

T 7 S R 43 E Sec 25

15

22.5

Ledge Creek Spring

Application No. 66745
Permit No. 50616

11SFS# 7-7395