


RECEIVED
SEP 26 1983
WATER RESOURCES DEPT.
SALEM, OREGON

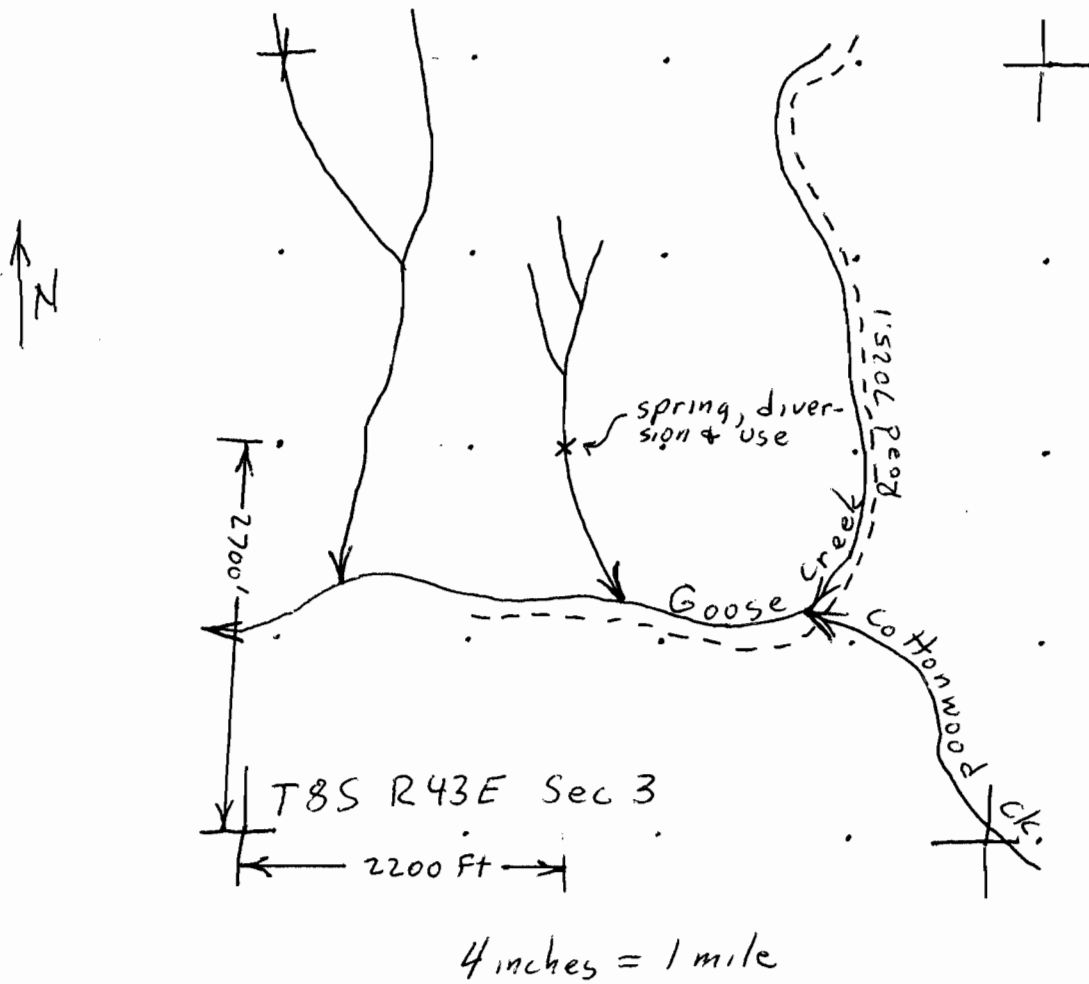

Application No. 66736
Permit No. 50609