


RECEIVED

SEP 26 1983
WATER RESOURCES DEPT.
SALEM, OREGON

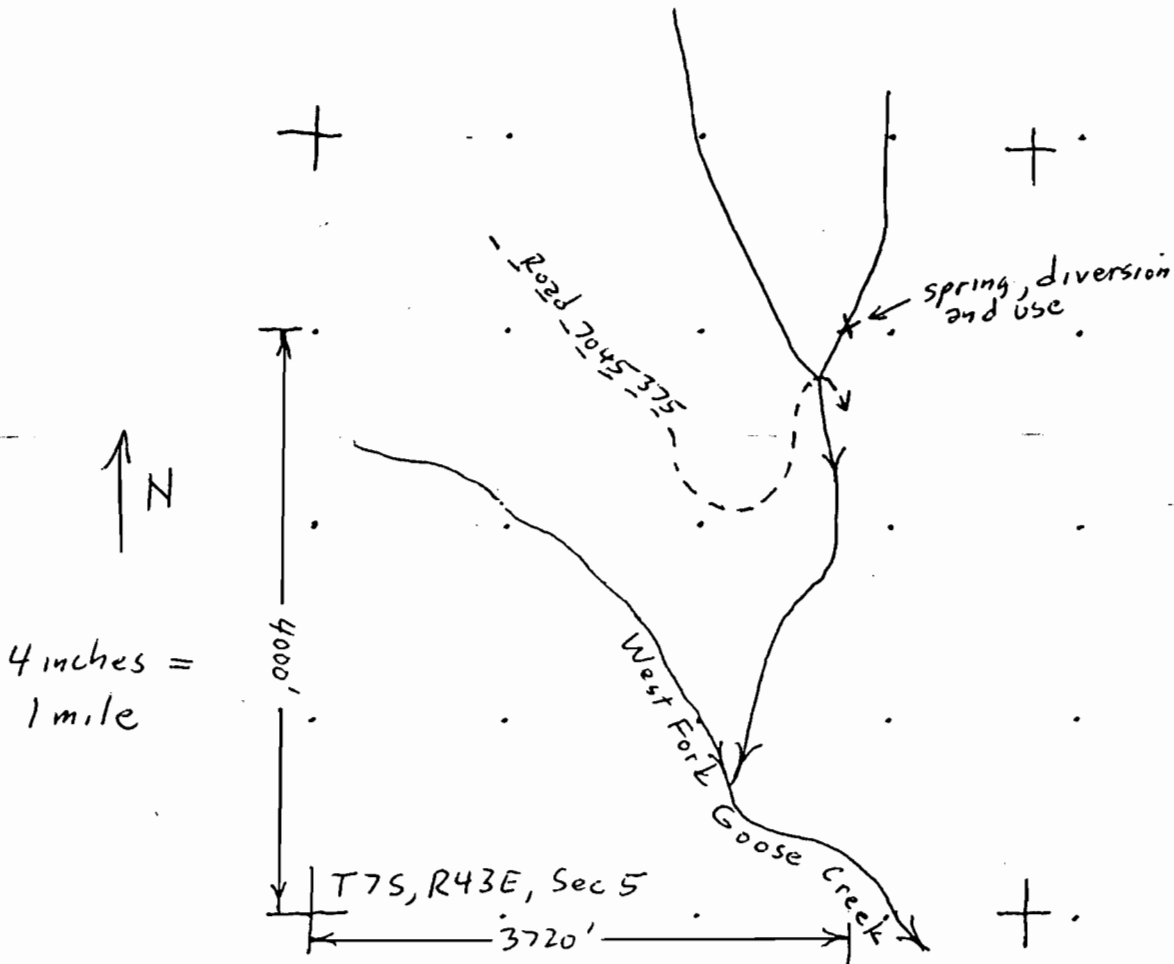

Location Blow-up
(not to scale)



Application No. 66737
Permit No. 50610