


RECEIVED

SEP 26 1983
WATER RESOURCES DEPT.
SALEM, OREGON

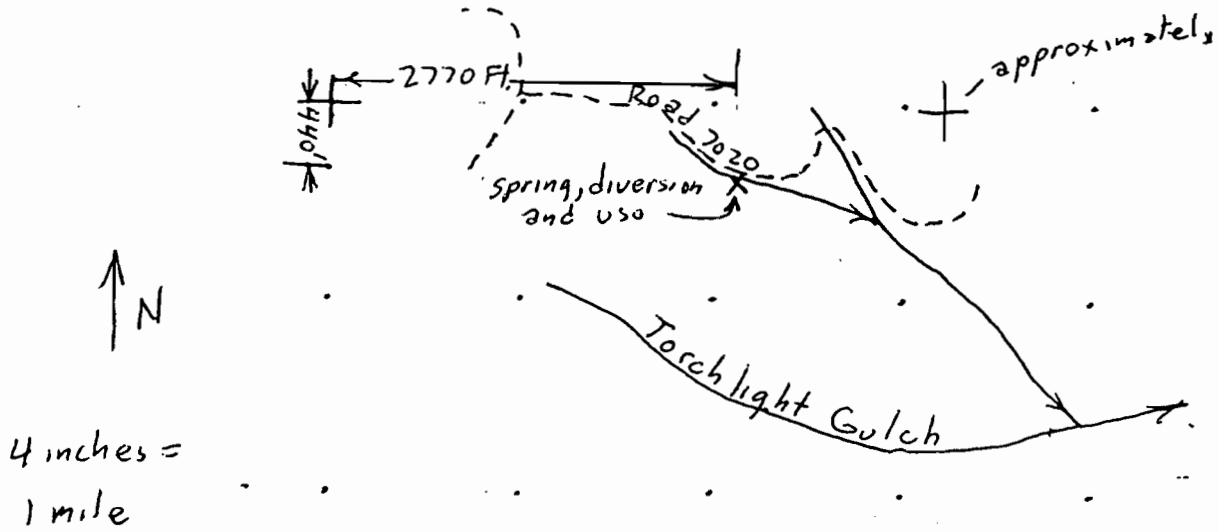

± T 7S, R 44E, Sec 18

± approximately

Location Blow-up
(not to scale)

Application No. 66738
Permit No. 50611



USFS #7-7377