


Glacier
Cabin
Camp

RECEIVED

SEP 26 1983

UNITED STATES DEPT.
SALEM, OREGON

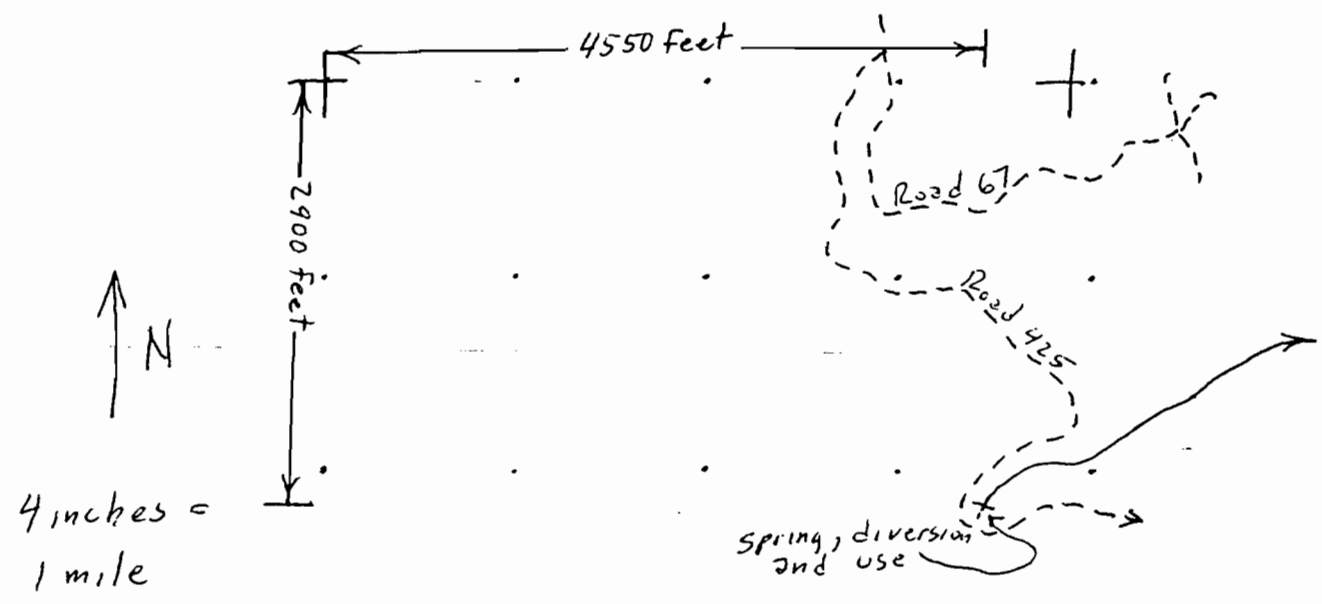

T6S R43E Sec 32

Application No. 66739
Permit No. 50612

USFS #7-7365