



SEP 26 1983
WATER RESOURCES DEPT.
SALEM, OREGON

4 inches = 1 mile

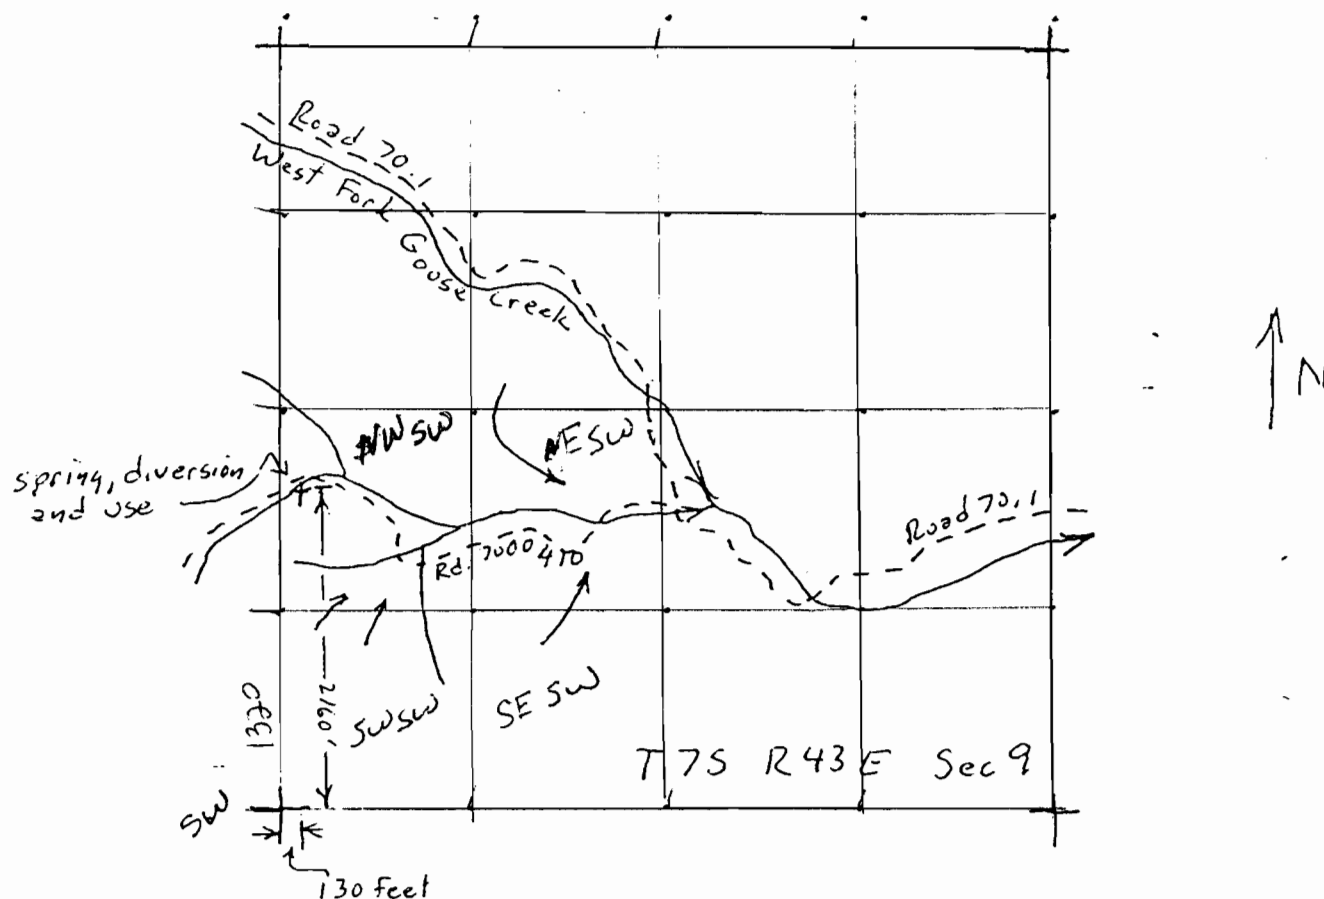

Location Blow-up
(not to scale)

1320

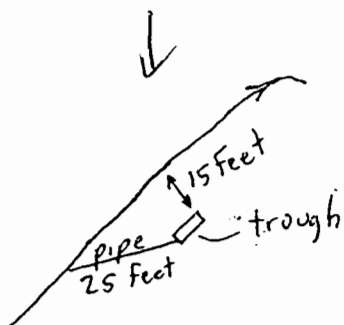

Application No. 66735
Permit No. 50608