


RECEIVED

SEP 26 1983

WATER RESOURCES DEPT.
SALEM, OREGON

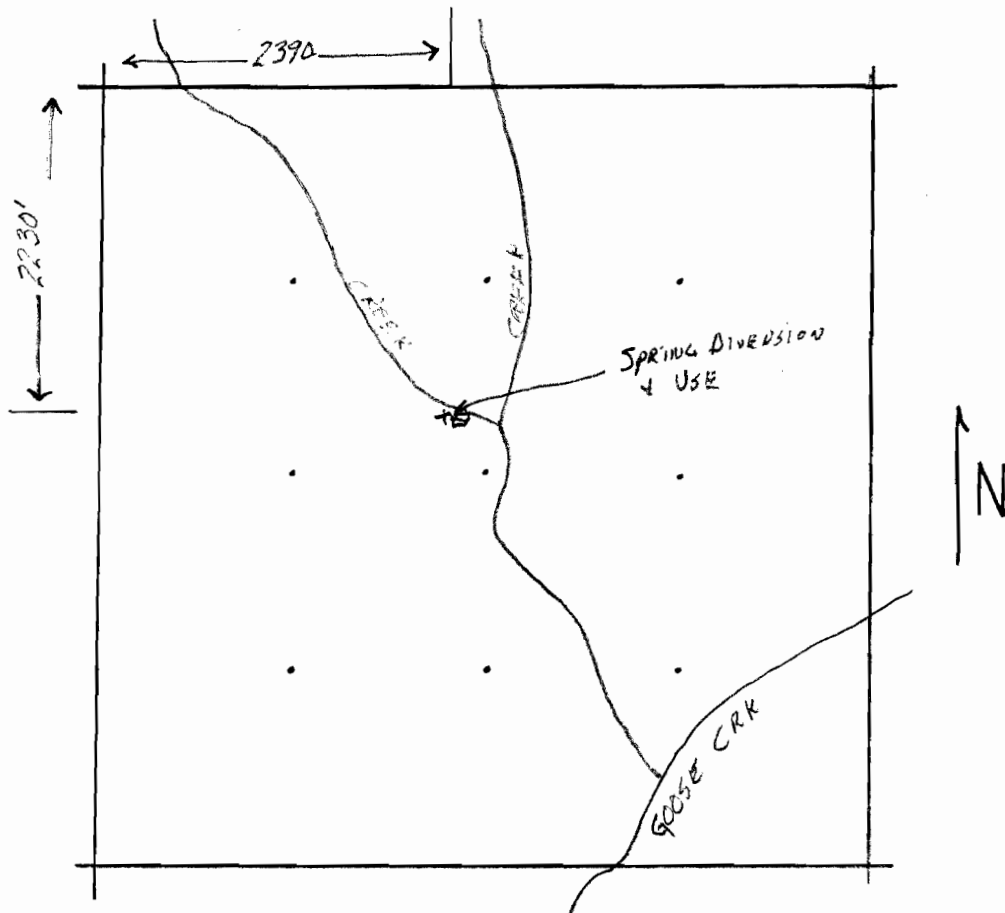

4 inches = 1 mile

T 7 S R 43 E Sec 34

Application No. 66734
Permit No. 50607