


T.20S.,R.27E.,W.M.

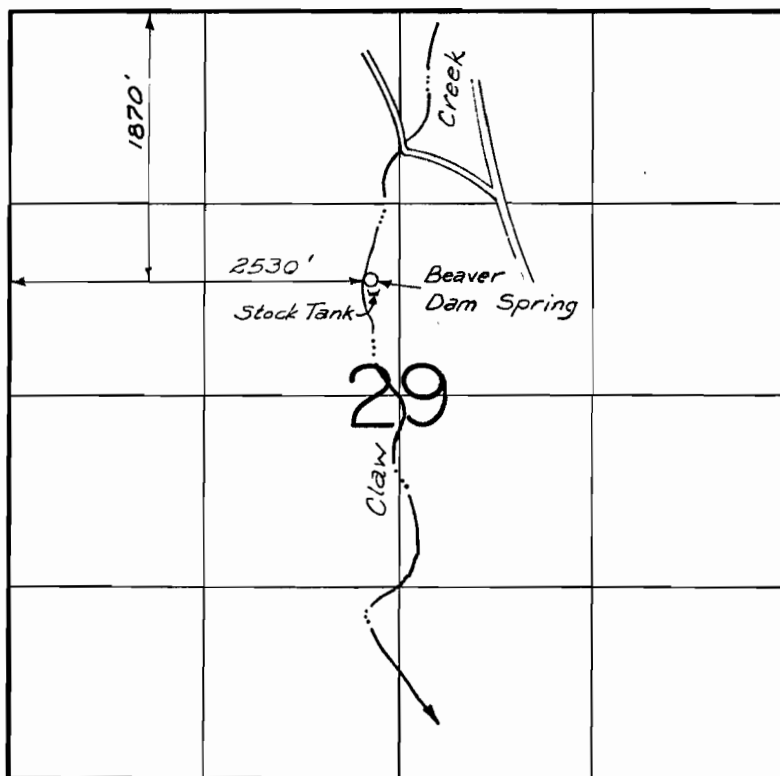

Scale 4" = 1 Mile

Application No. 60871
IN NAME OF
U. S. OCHOCO NATIONAL FOREST

Permit No. 48524

RECEIVED
MAY 6 1963
WATER RESOURCES DEPT.
SALEM, OREGON