


# T. 1S. R. 2W. W.M.

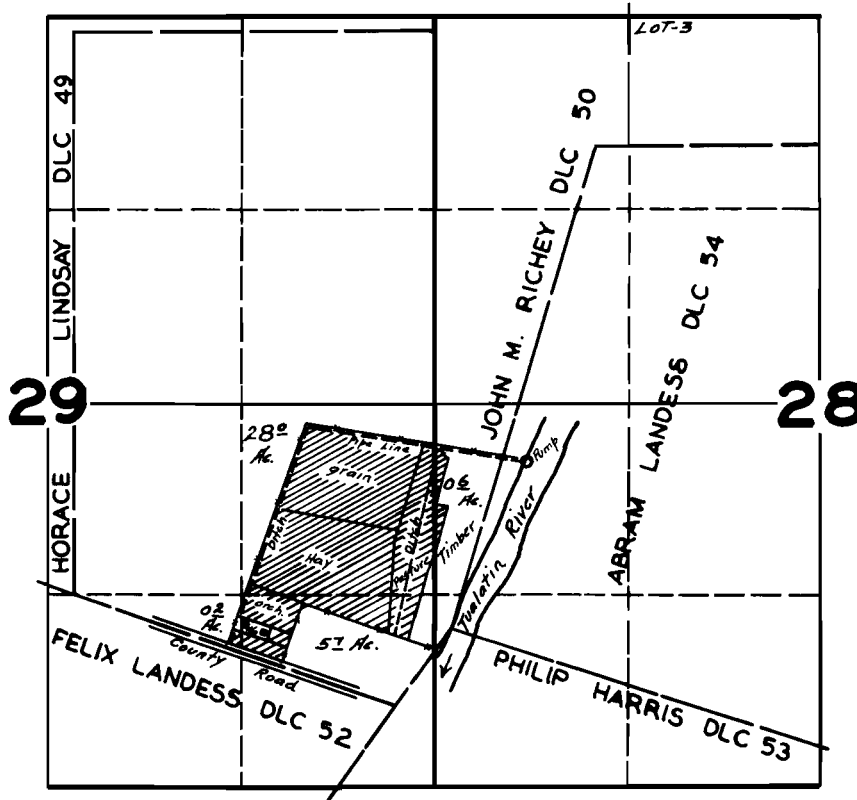

## FINAL PROOF SURVEY

UNDER

Application No. 17268 Permit No. 12979

IN NAME OF

EDWARD HATFIELD

Surveyed AUG. 3, 1944, by [Signature]