T.26S. R.14&15E. W.M.

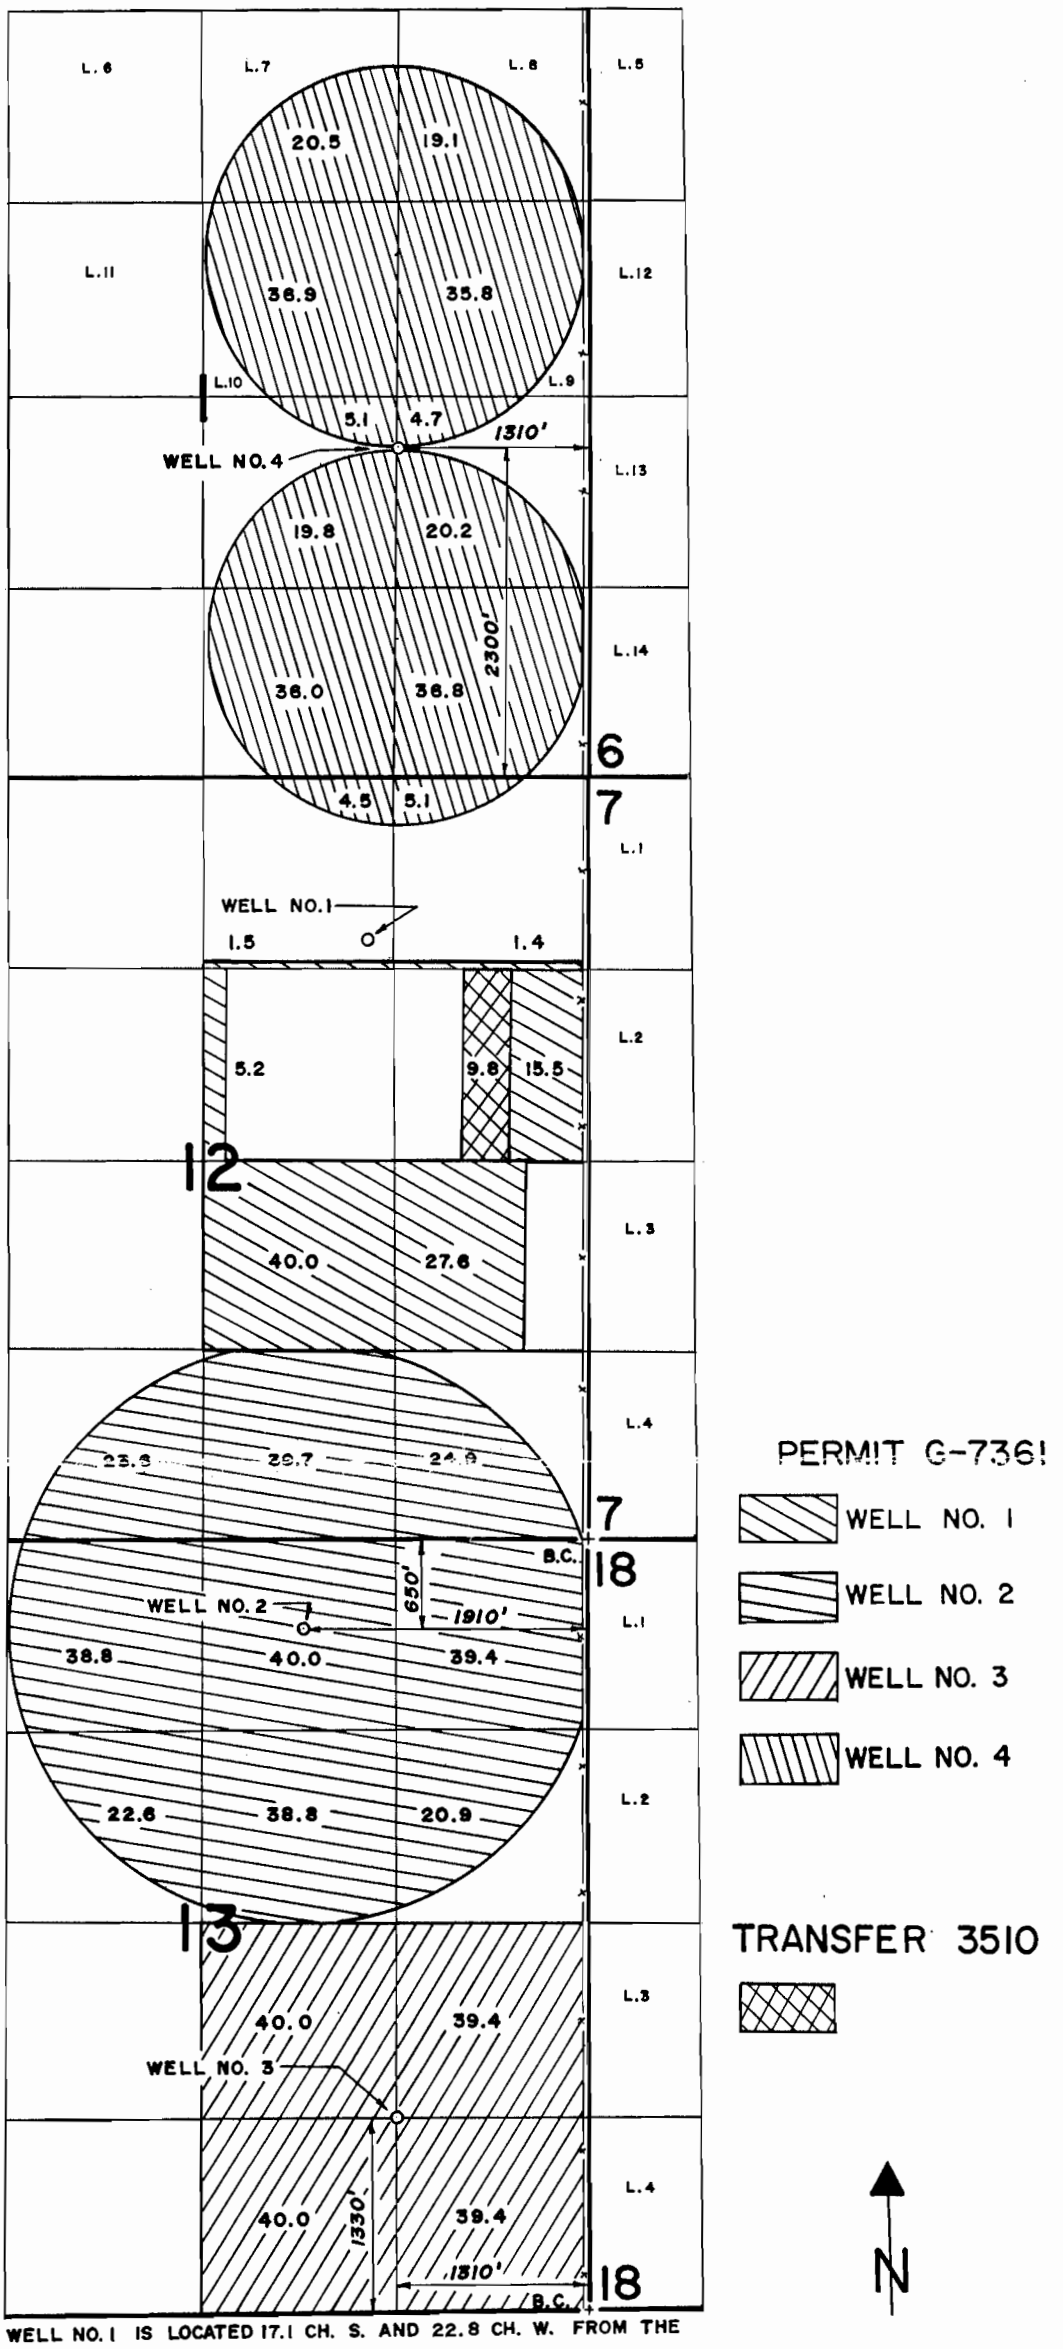

WELL NO. 1 IS LOCATED 17.1 CH. S. AND 22.8 CH. W. FROM THE N.E. COR. OF SECTION 12.

SCALE: 4" = 1 MILE

FINAL PROOF SURVEY

UNDER

TRANSFER NO. 3510
AND
APPLICATION NO. G-7651 PERMIT NO. G-7361

IN NAME OF

KENNETH V. KRUSE & KATHLEEN G. KRUSE

SURVEYED OCT. 14, 1984 BY P. R. PAGTER

PRP PTS 11/27/84