


T.15S.R.43E.W.M.

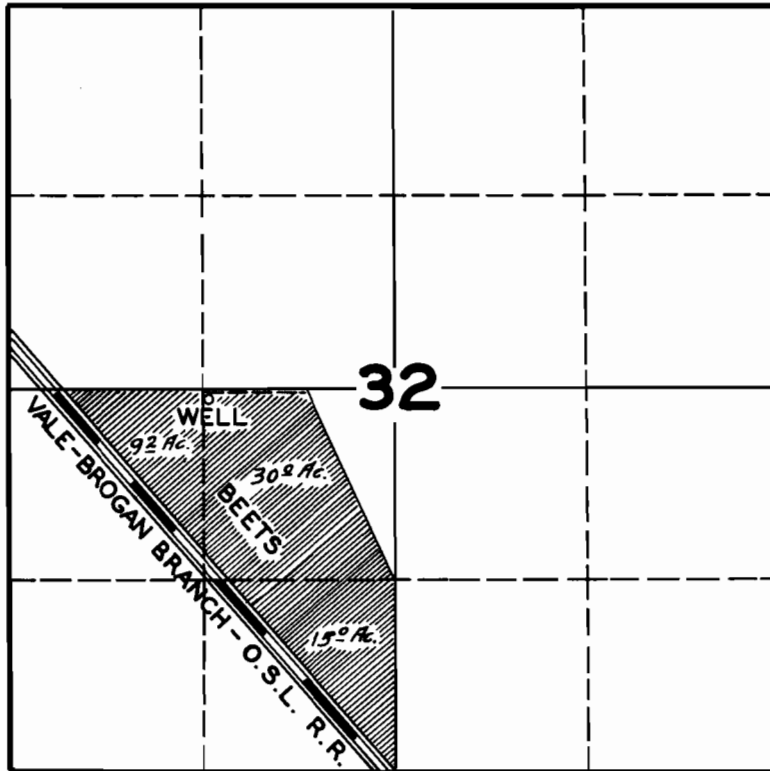

FINAL PROOF SURVEY

UNDER

Application No. U-167 Permit No. U-161

IN NAME OF

JOHN M. SCHOLTES

Surveyed MAY 31, 1946, by

A handwritten signature in cursive script, appearing to read 'J. M. Scholtes', is written over the printed name and extends across the 'Surveyed' line.