


T. 15S. R. 42E. WM.

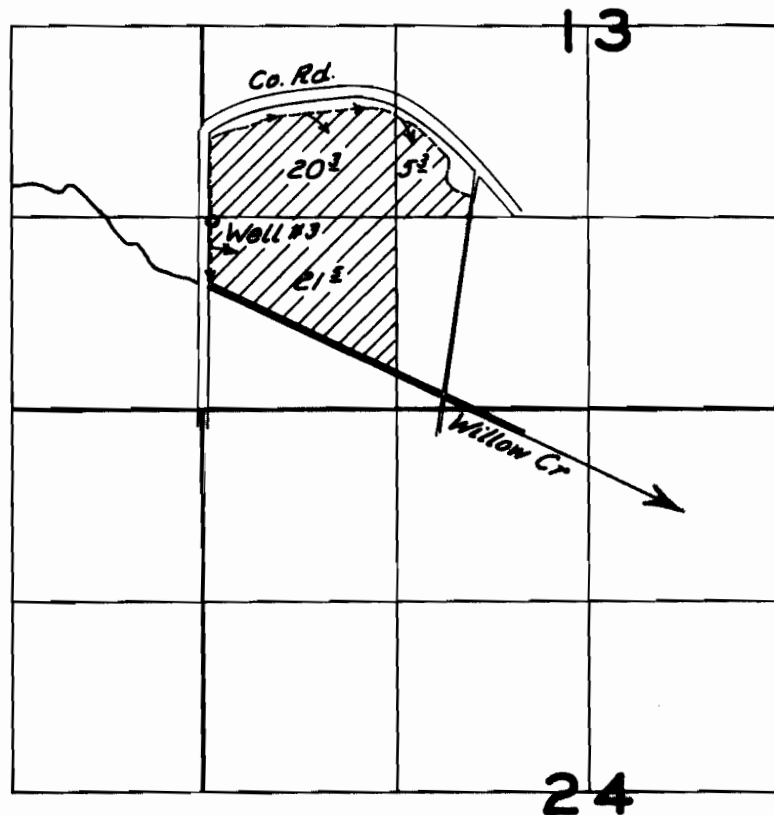

FINAL PROOF SURVEY

UNDER

Application No. *G794* Permit No. *GB46*

IN NAME OF

Tony O. Tomasello & Tony Scurich, Jr.

Surveyed *Sept. 22 19 59.*, by *R.H. Jackson*...