


T. 15S., R. 43E., W.M.

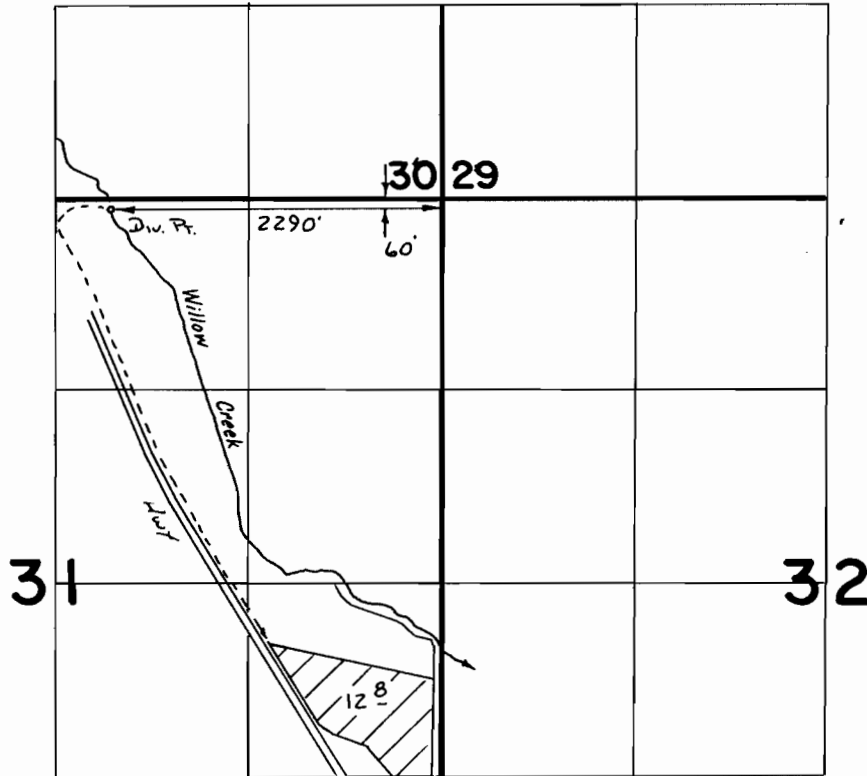

SCALE 1" = 1320'

FINAL PROOF SURVEY

UNDER

Application No. **65183** Permit No. **47843**
IN NAME OF

EUGENE SMITH, SMITH CATTLE COMPANY

Surveyed *6-12* 19*86*, by *V.L. Church*