


T.15 S. R. 42 E. W.M.

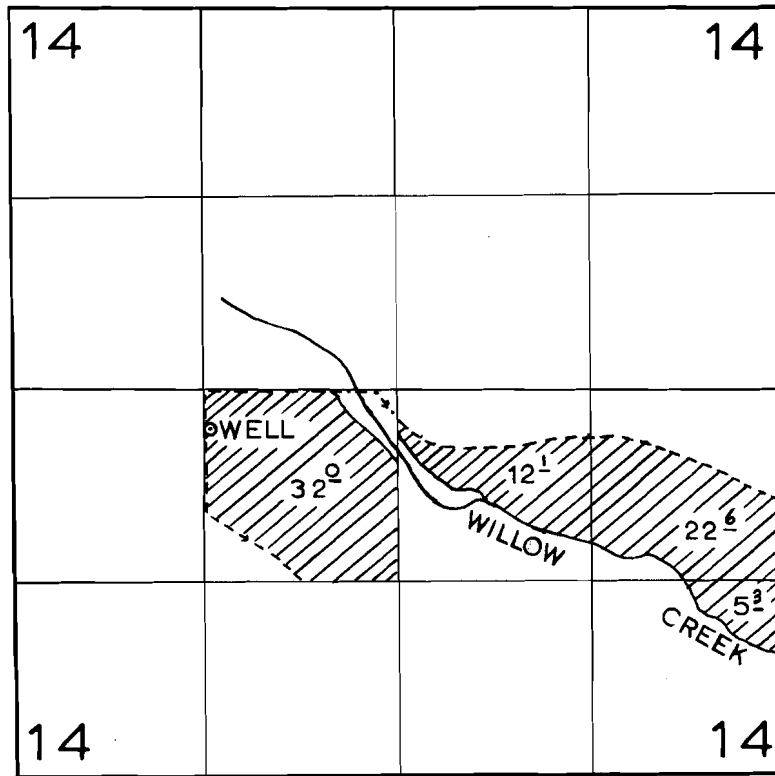

FINAL PROOF SURVEY
UNDER

Application No. G-2060 . Permit No. G-1888
IN NAME OF

F. A. PUGH

Surveyed NOV. 16 . 1964., by *F. W. Elfring*