


T. 15S. R. 42E. W.M.

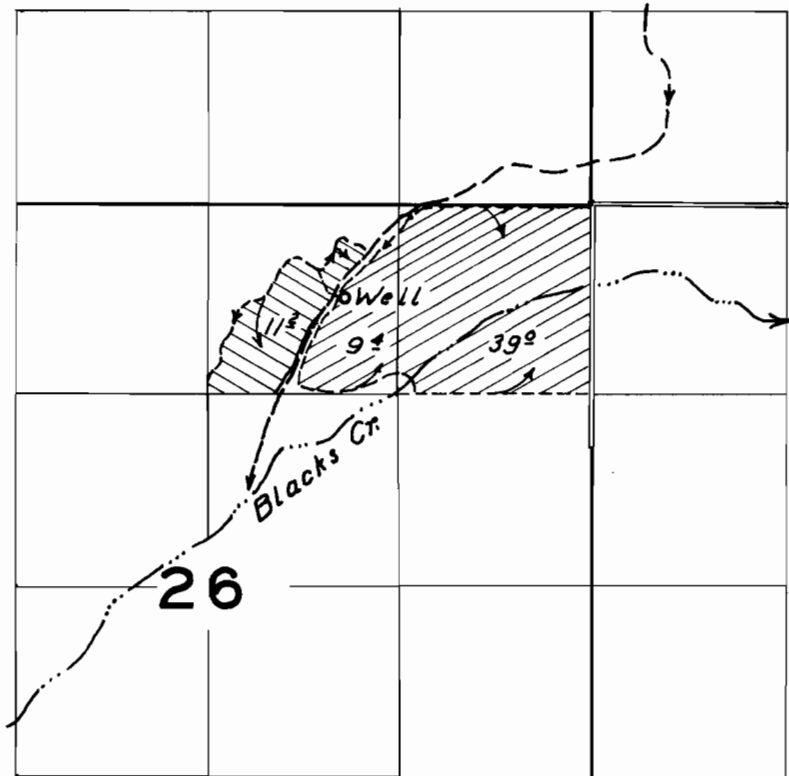

Supplemental  Primary 

FINAL PROOF SURVEY

UNDER

Application No. *U 367* Permit No. *U 346*.....

IN NAME OF

M. J. Vilsmeier

Surveyed *Sept. 22 19 59*.., by *B. H. Jackson*