
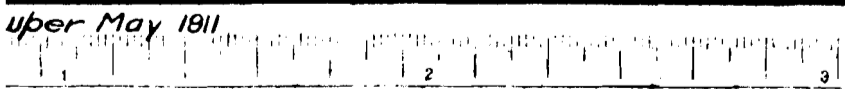


Township 9 South

Range 45 East

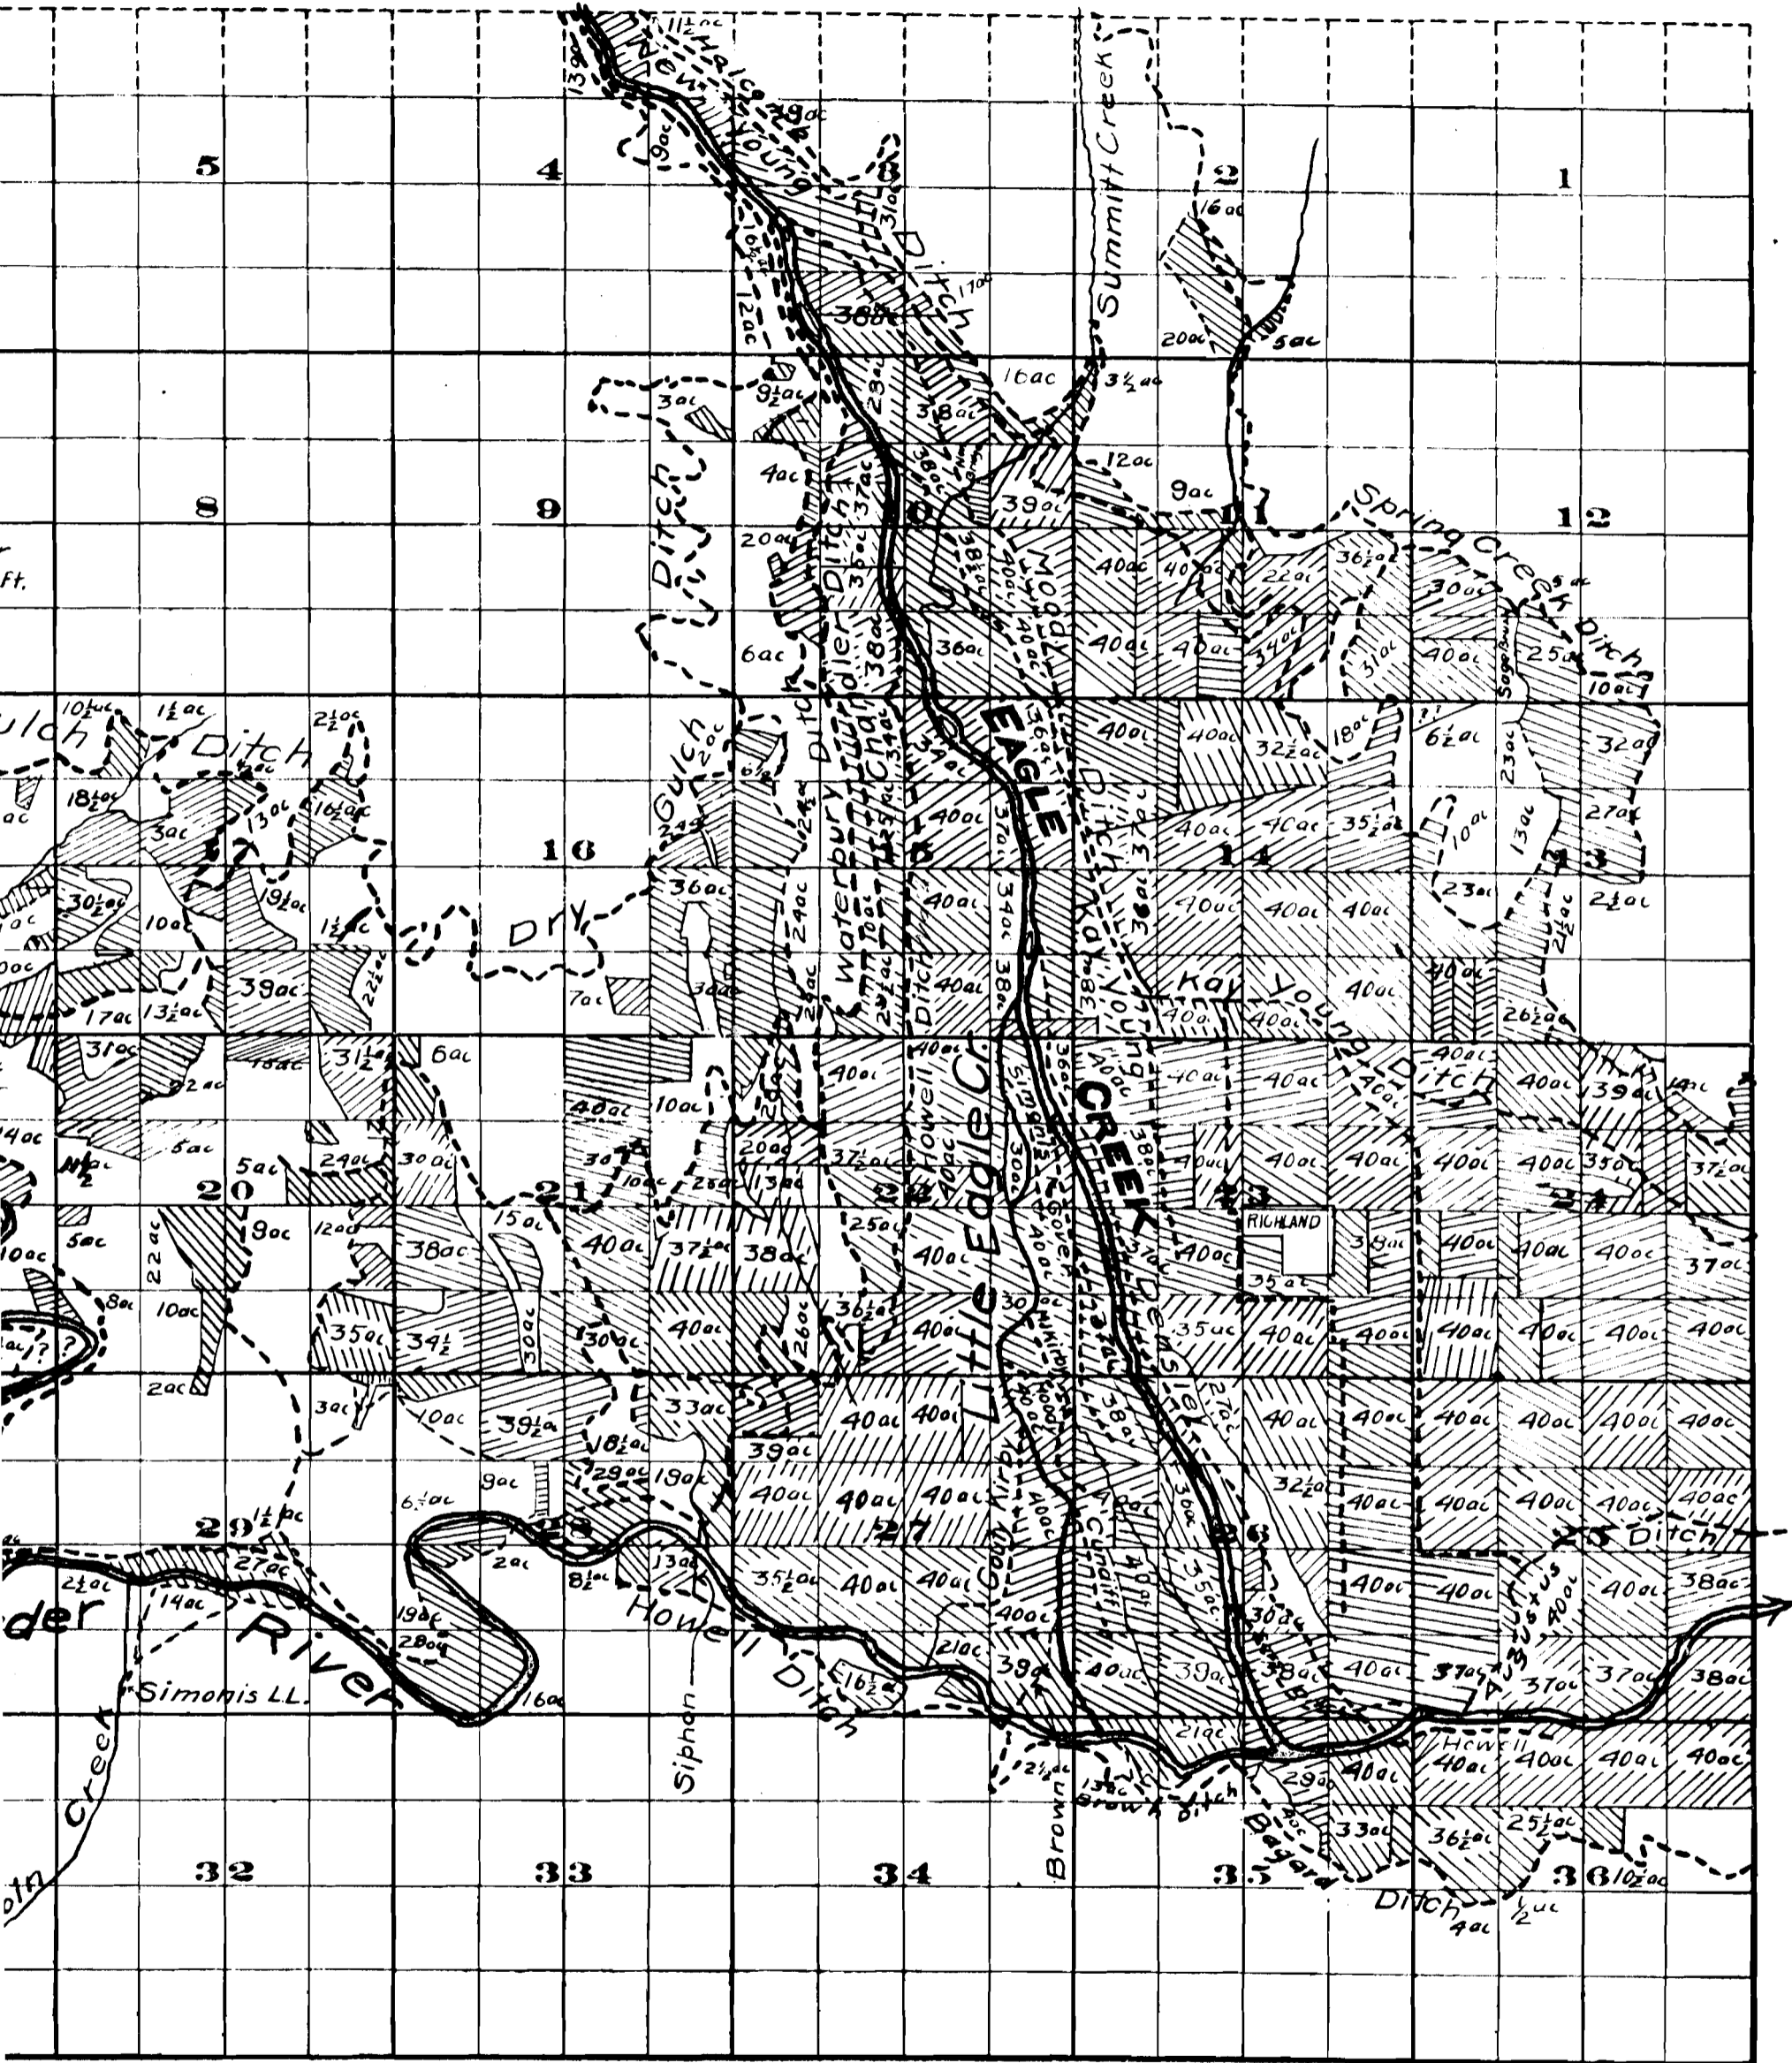

FROM OFFICE OF THE STATE ENGINEER, SALEM, OREGON

Scale of Feet.

land with area

Powder River Adjudication

John H. Lewis State Engineer

Examined June 6 1912