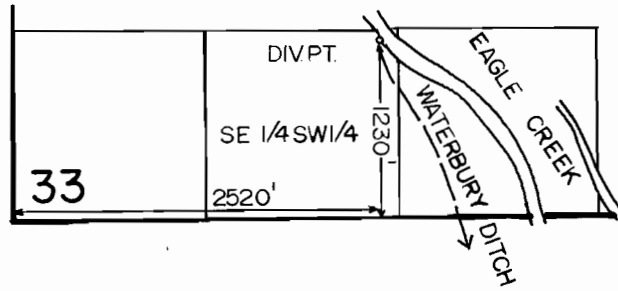
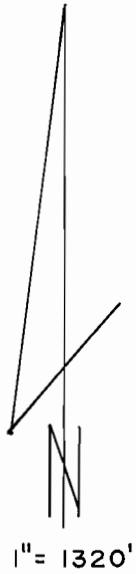
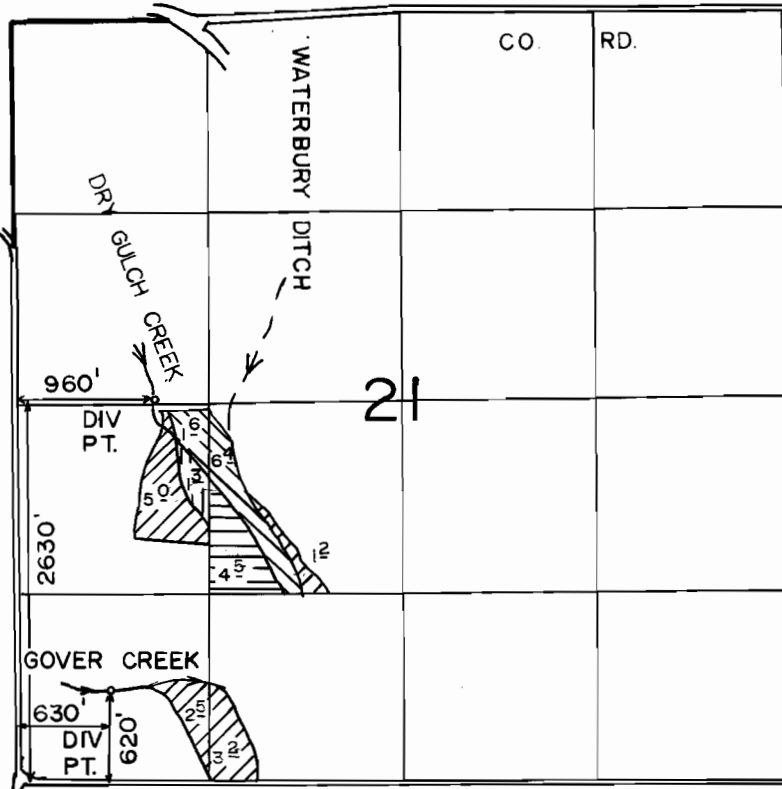
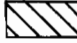
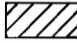

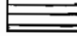


SEC. 33 T. 8 S., R. 45 E., W.M.



T. 9 S., R. 45 E., W.M.



-  PRIMARY
-  priority 1891, 2-23-16, 12-28-62
-  priority 1891, 2-23-16
-  priority 1891

FINAL PROOF SURVEY
UNDER

Application No. 59820... Permit No. 45438.....

IN NAME OF

TIMOTHY E. & JANICE M. HEATER

Surveyed AUGUST. 9 1990., by K. KEMP.....

1-11-91 DSM

BBB-2KK-93