


# T.9S. R.45E.W.M.

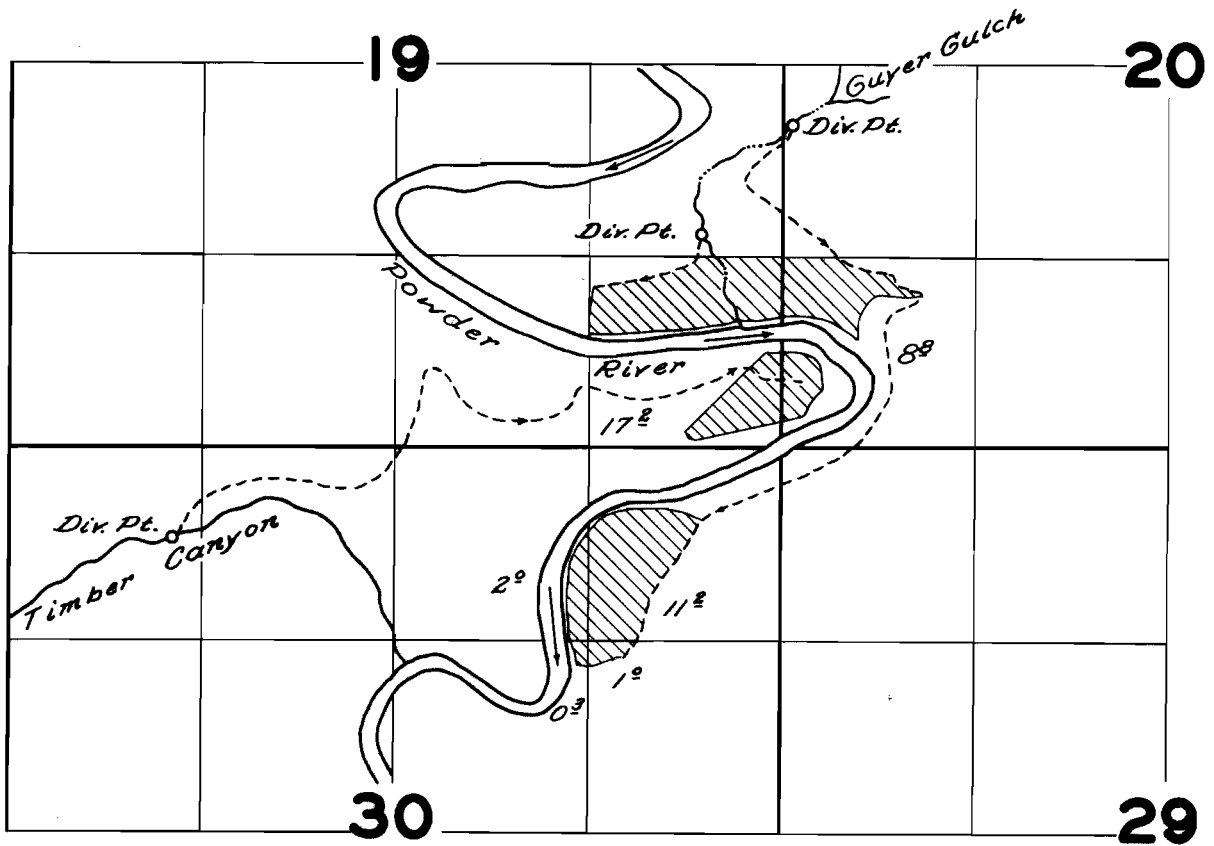

## FINAL PROOF SURVEY UNDER

Application No. 17325... Permit No. 13139...  
IN NAME OF

*Elbert Dennis*

Surveyed *Sept. 17* 1958, by *C.O. Bastile*...