

UNITED STATES
DEPARTMENT OF THE INTERIOR
BUREAU OF LAND MANAGEMENT

R 2435
75371


SECTION

Oregon State Water Filings

TOWNSHIP 28S, RANGE 13E, W. M.

RECEIVED
JUN 10 1960

North

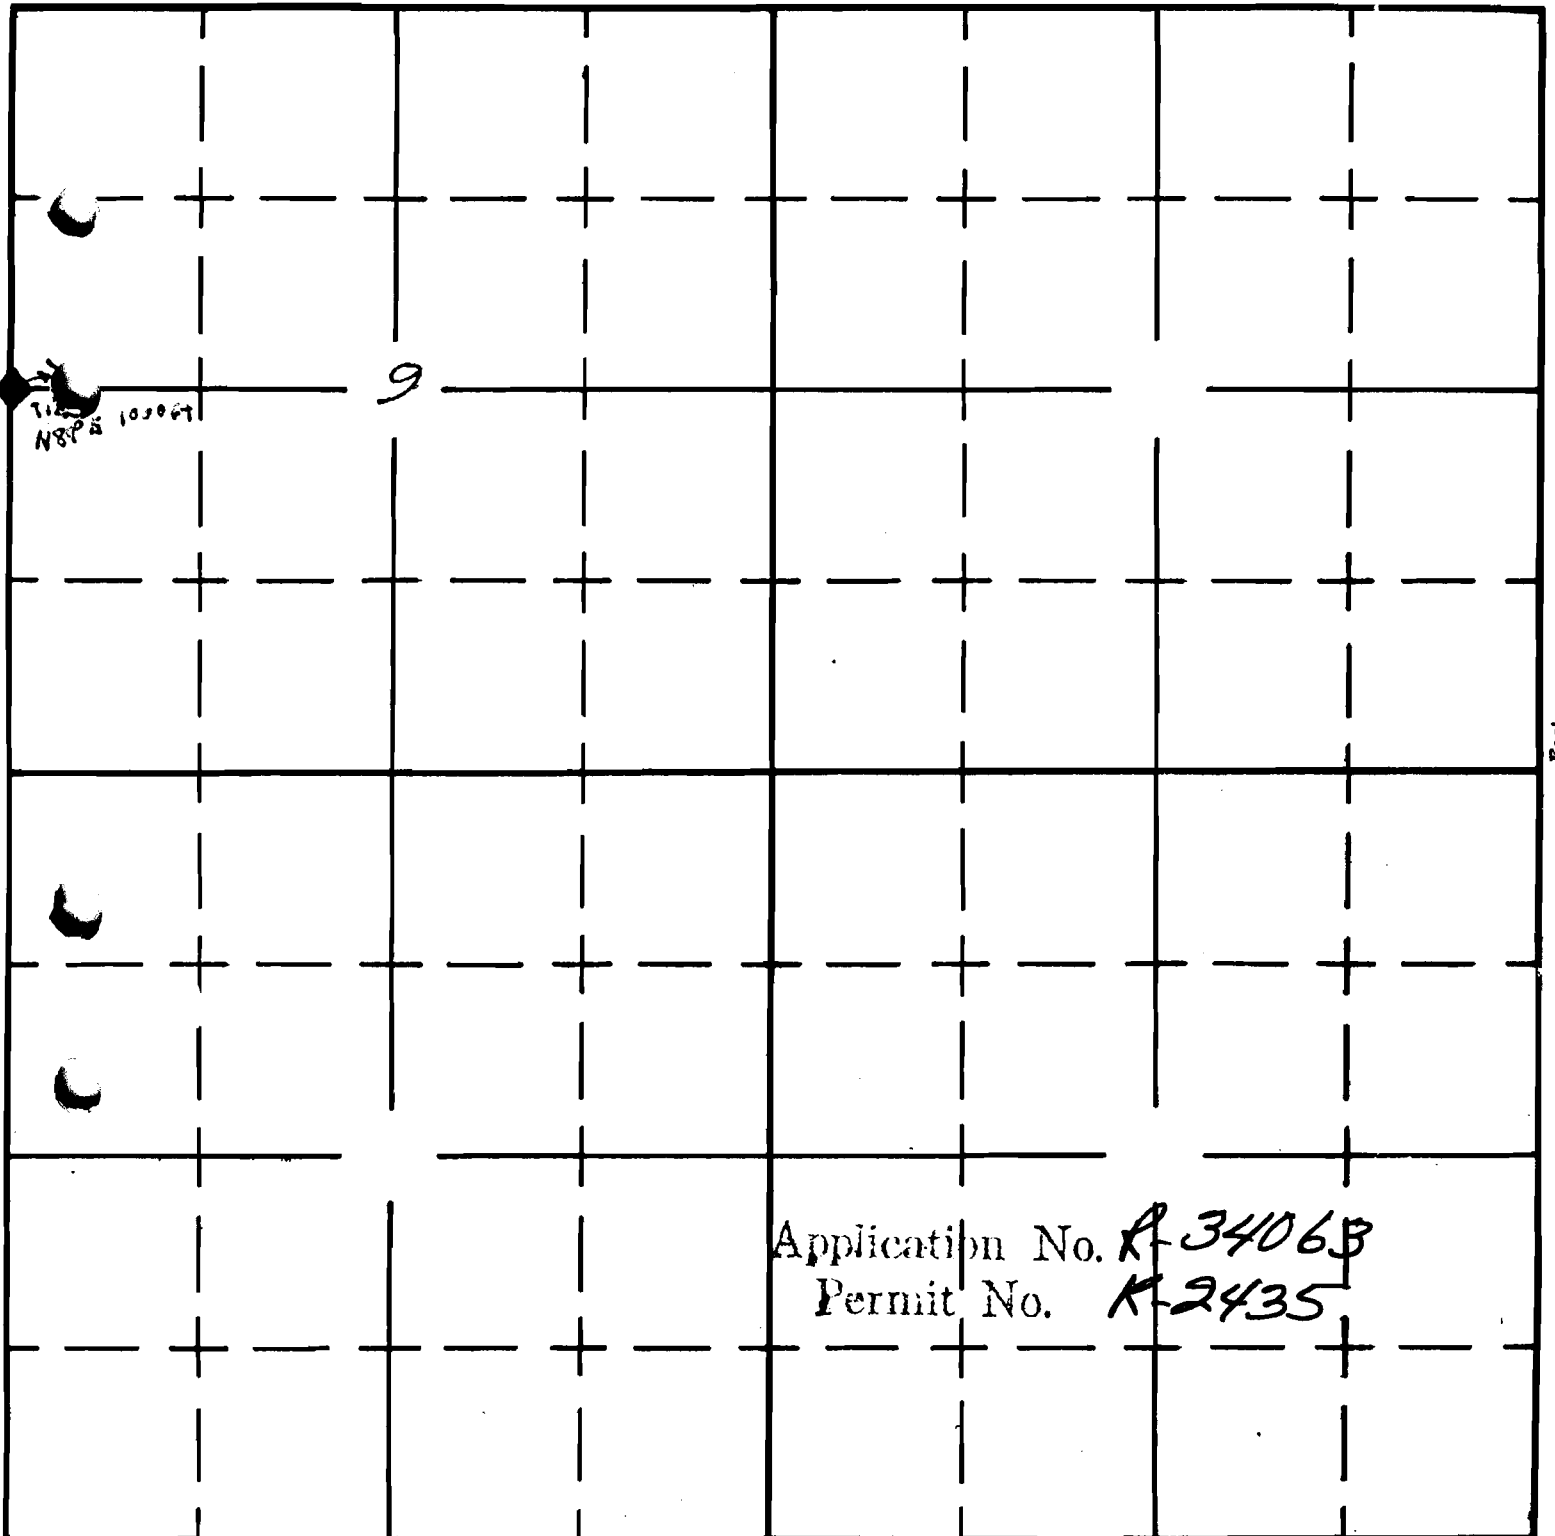

Application No. R-3406B
Permit No. R-2435

◆ FOUND SURVEY CORNER
W PROJECT

South

APPLICATION No.
PERMIT No.