

UNITED STATES
DEPARTMENT OF THE INTERIOR
BUREAU OF LAND MANAGEMENT

R-2440
75372

SECTION


15

Oregon State Water Filings

TOWNSHIP 28S, RANGE 13E, W. M.

RECEIVED
FEB 28 1961
STATE ENGINEER

North

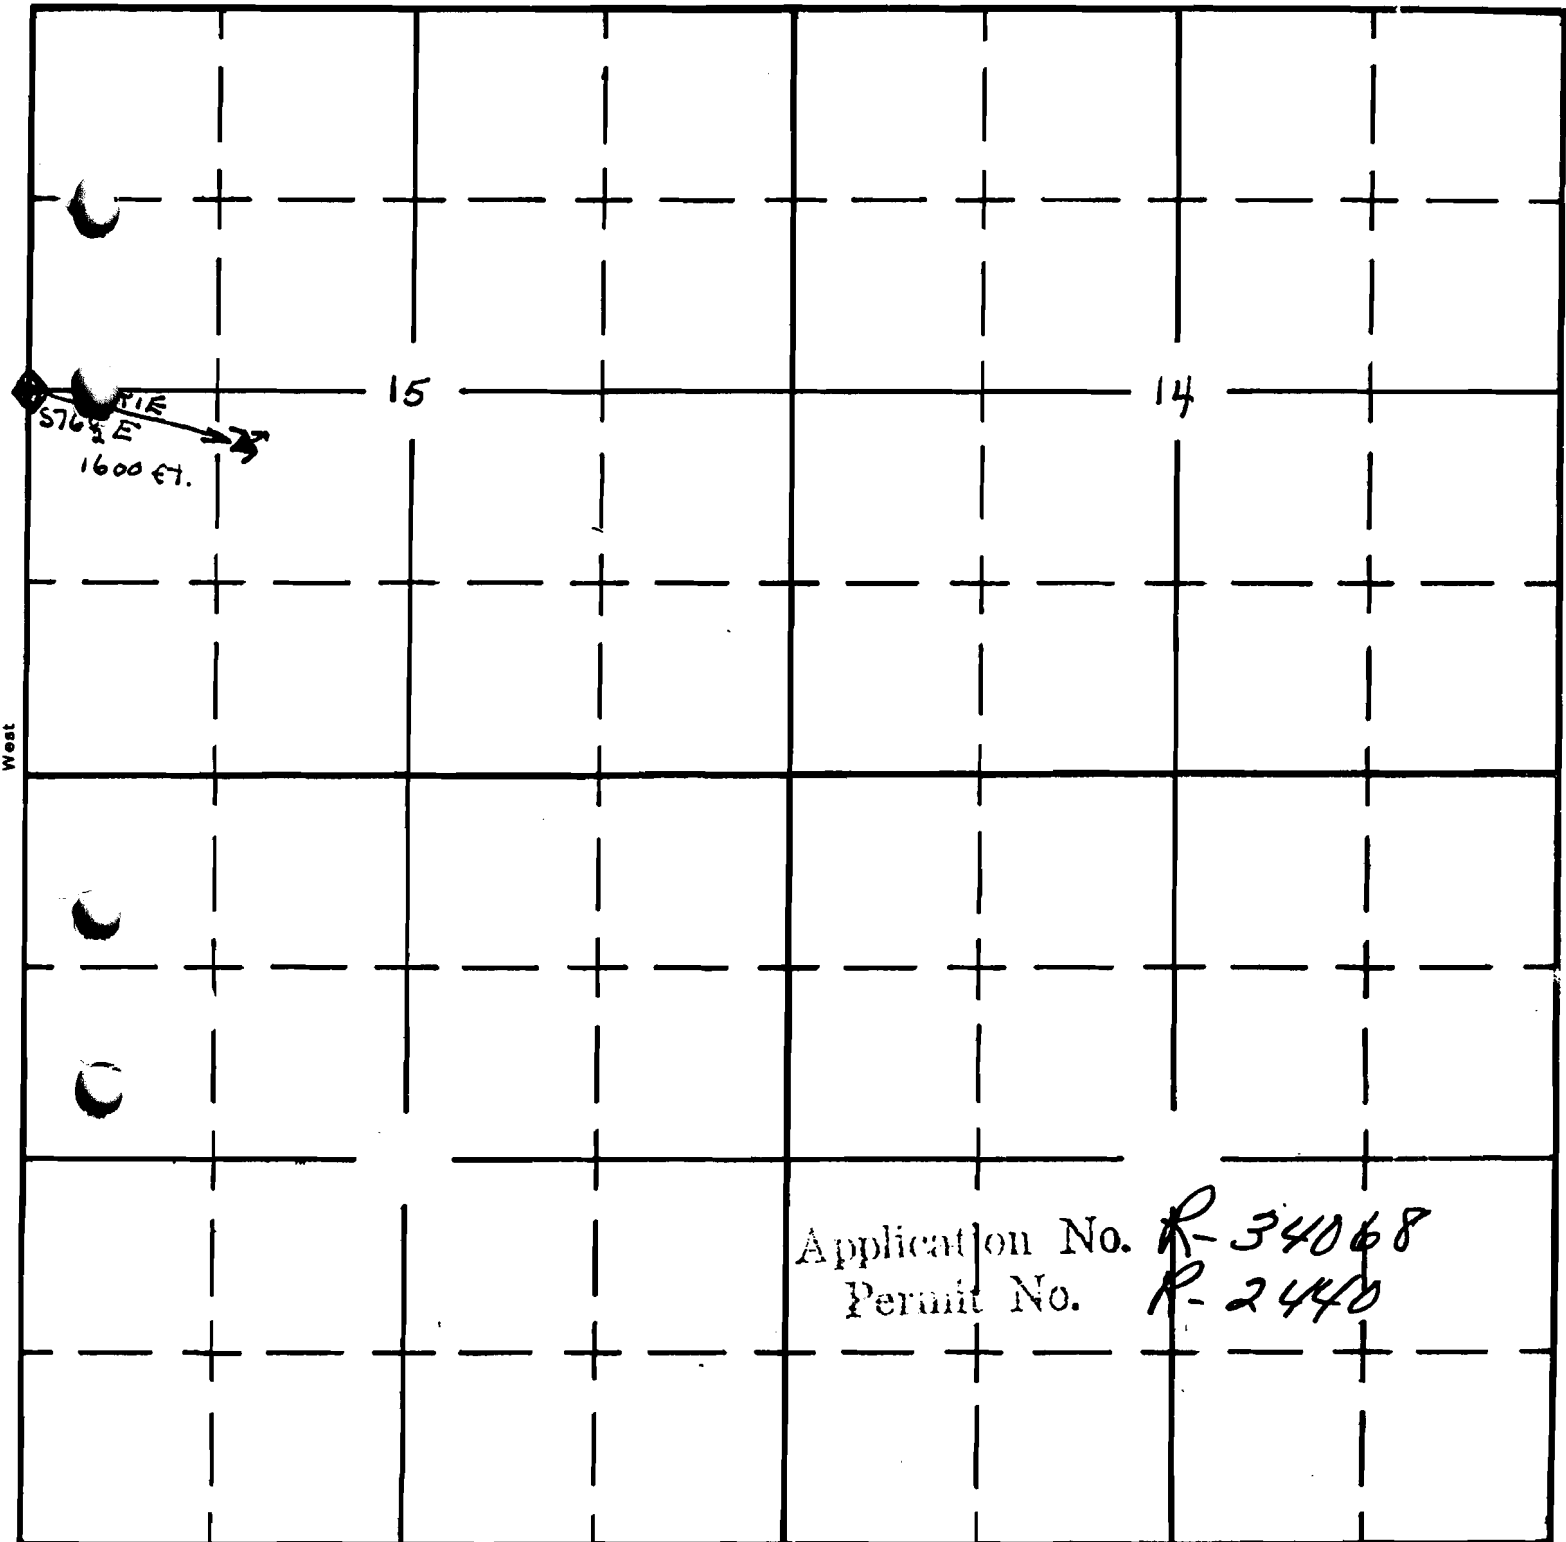

Application No.
Permit No.

R-34068
R-2440

◆ FOUND SURVEY CORNER

South

W PROJECT

APPLICATION No.
PERMIT No.