

UNITED STATES
DEPARTMENT OF THE INTERIOR
BUREAU OF LAND MANAGEMENT


R-2436
75373

SECTION

Oregon State Water Filings

TOWNSHIP 28S, RANGE 13E, W. M.

North

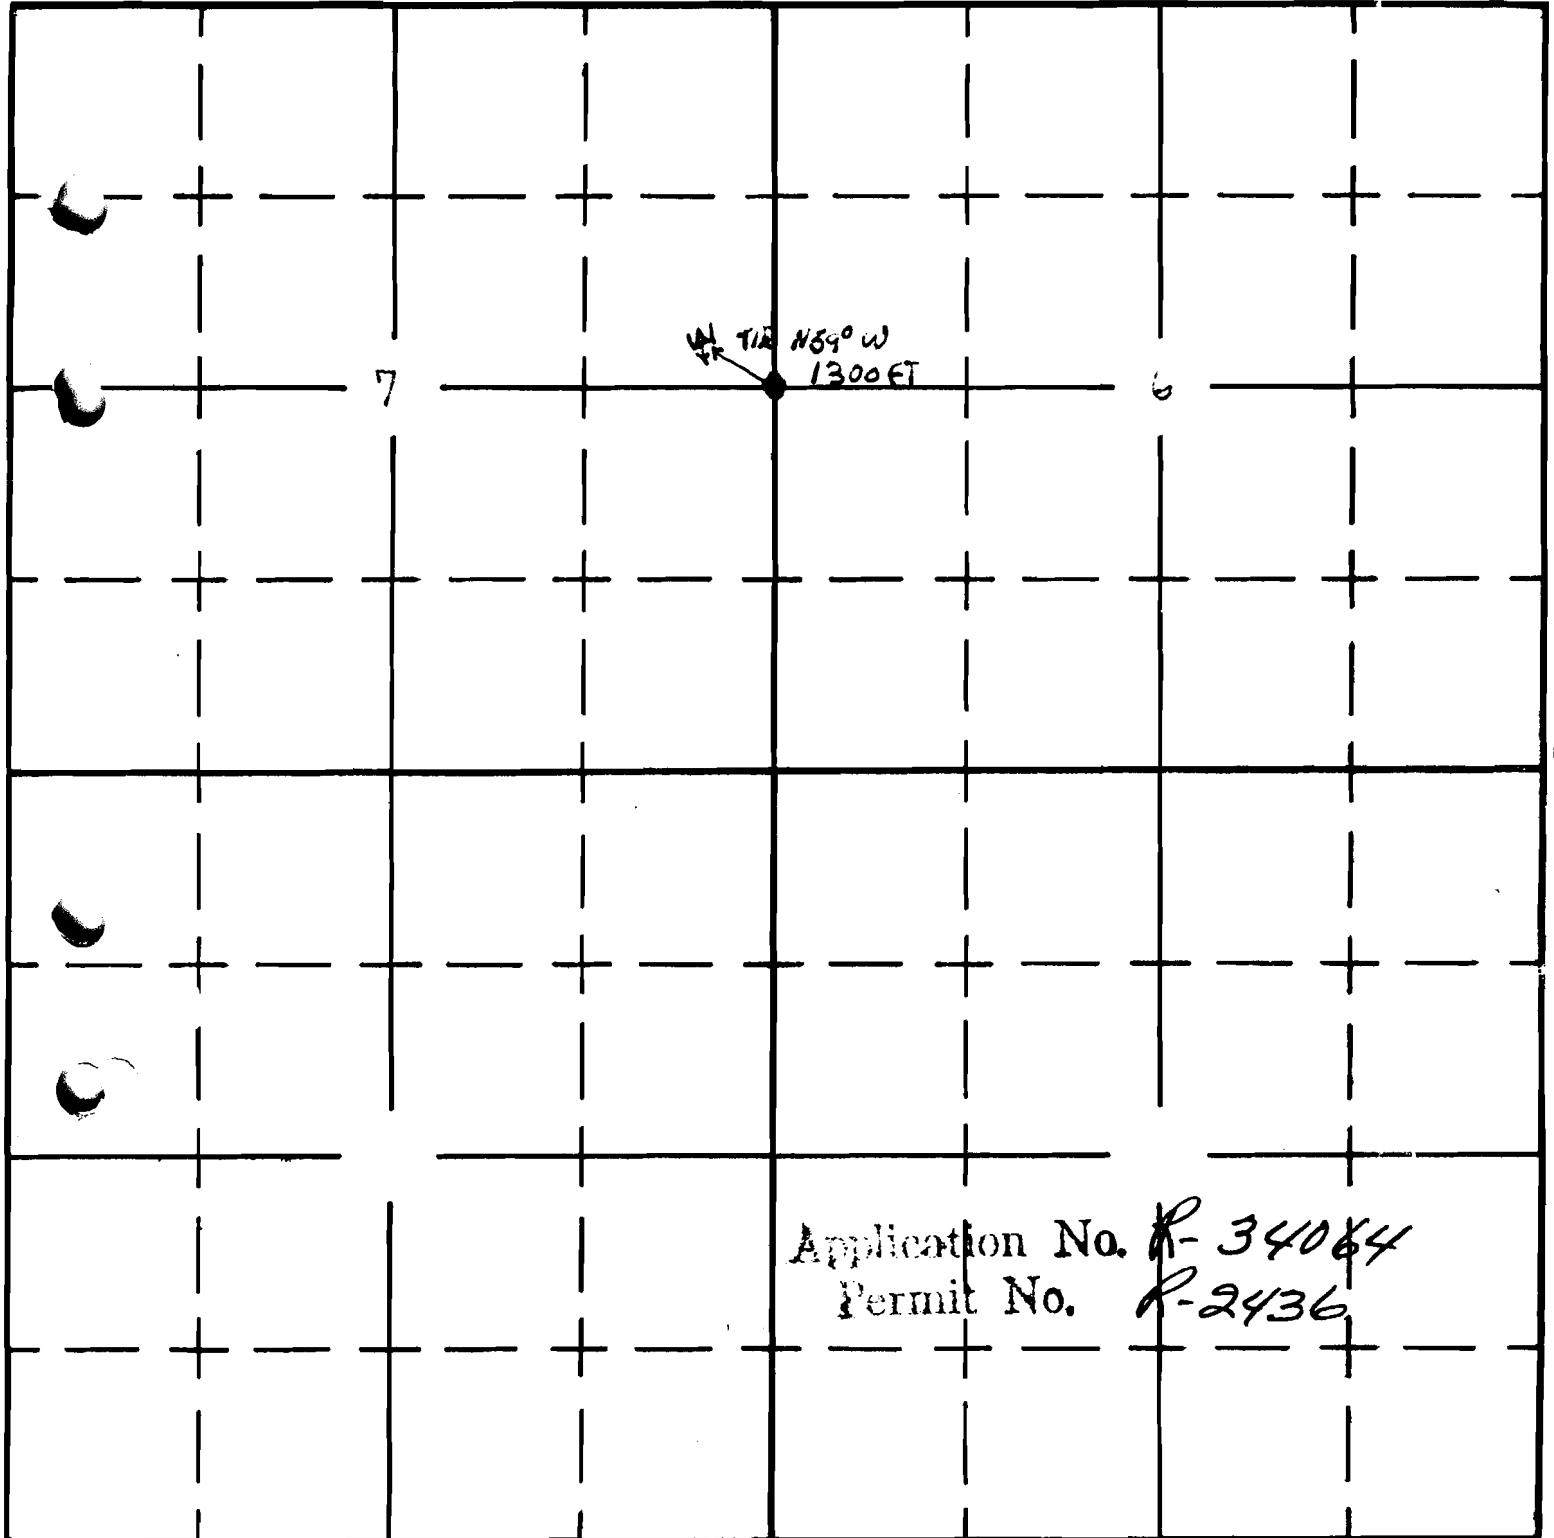

Application No. R-34064
Permit No. R-2436

◆ FOUND SURVEY CORNER

South

W PROJECT

APPLICATION No.

PERMIT No.