


UNITED STATES
DEPARTMENT OF THE INTERIOR
BUREAU OF LAND MANAGEMENT

SECTION

Oregon State Water Filings

TOWNSHIP 29S, RANGE 14E, W. M.

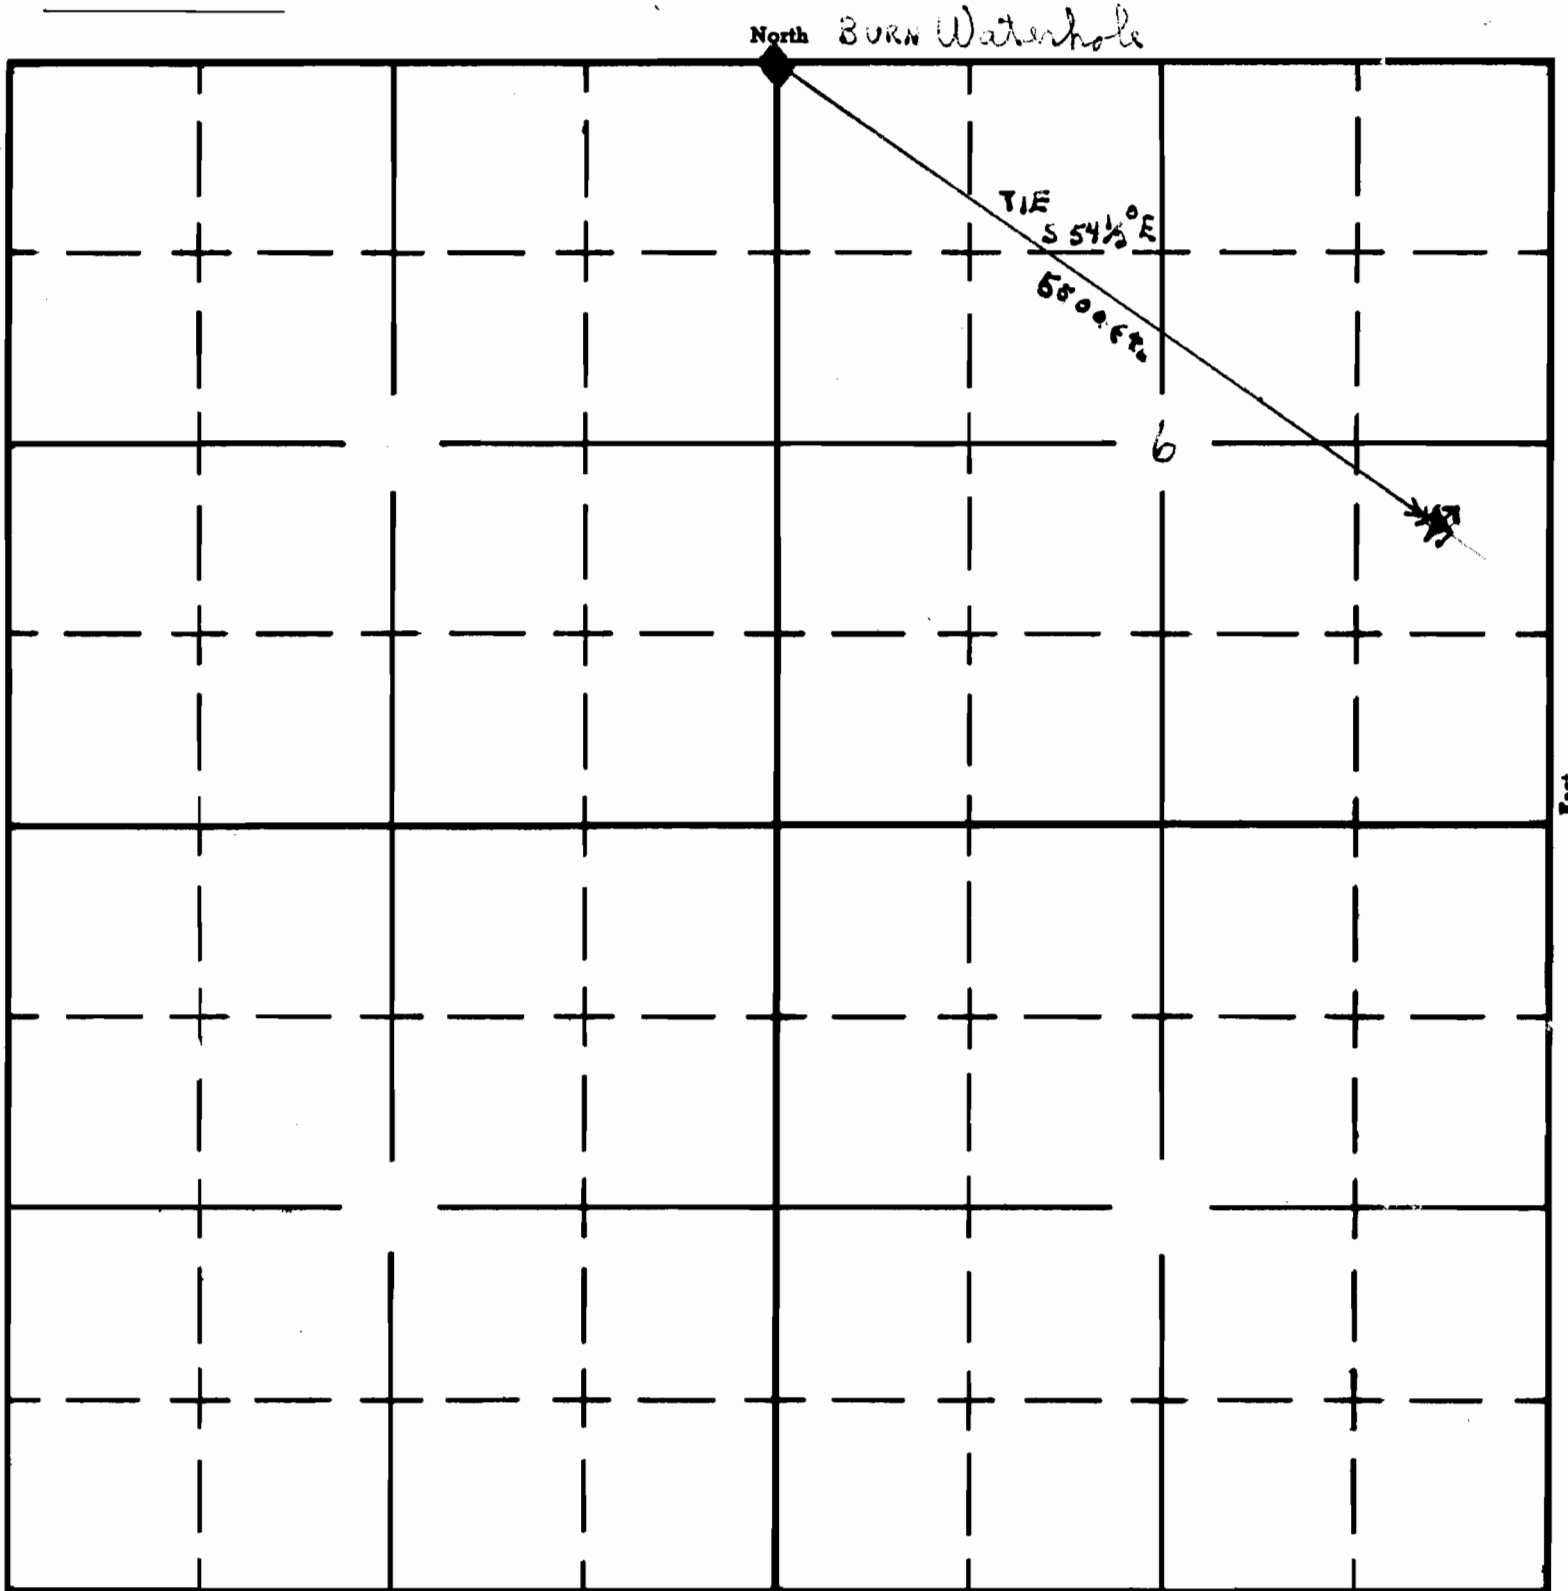

◆ FOUND SURVEY CORNER Application No. R-34233

✱ PROJECT

Permit No. R-2485

APPLICATION No.

PERMIT No.