

UNITED STATES
DEPARTMENT OF THE INTERIOR
BUREAU OF LAND MANAGEMENT


R-2486
75376

SECTION

Oregon State Water Filings

TOWNSHIP 29S, RANGE 14E, W. M.

North Washed Waterhole Reconstruction

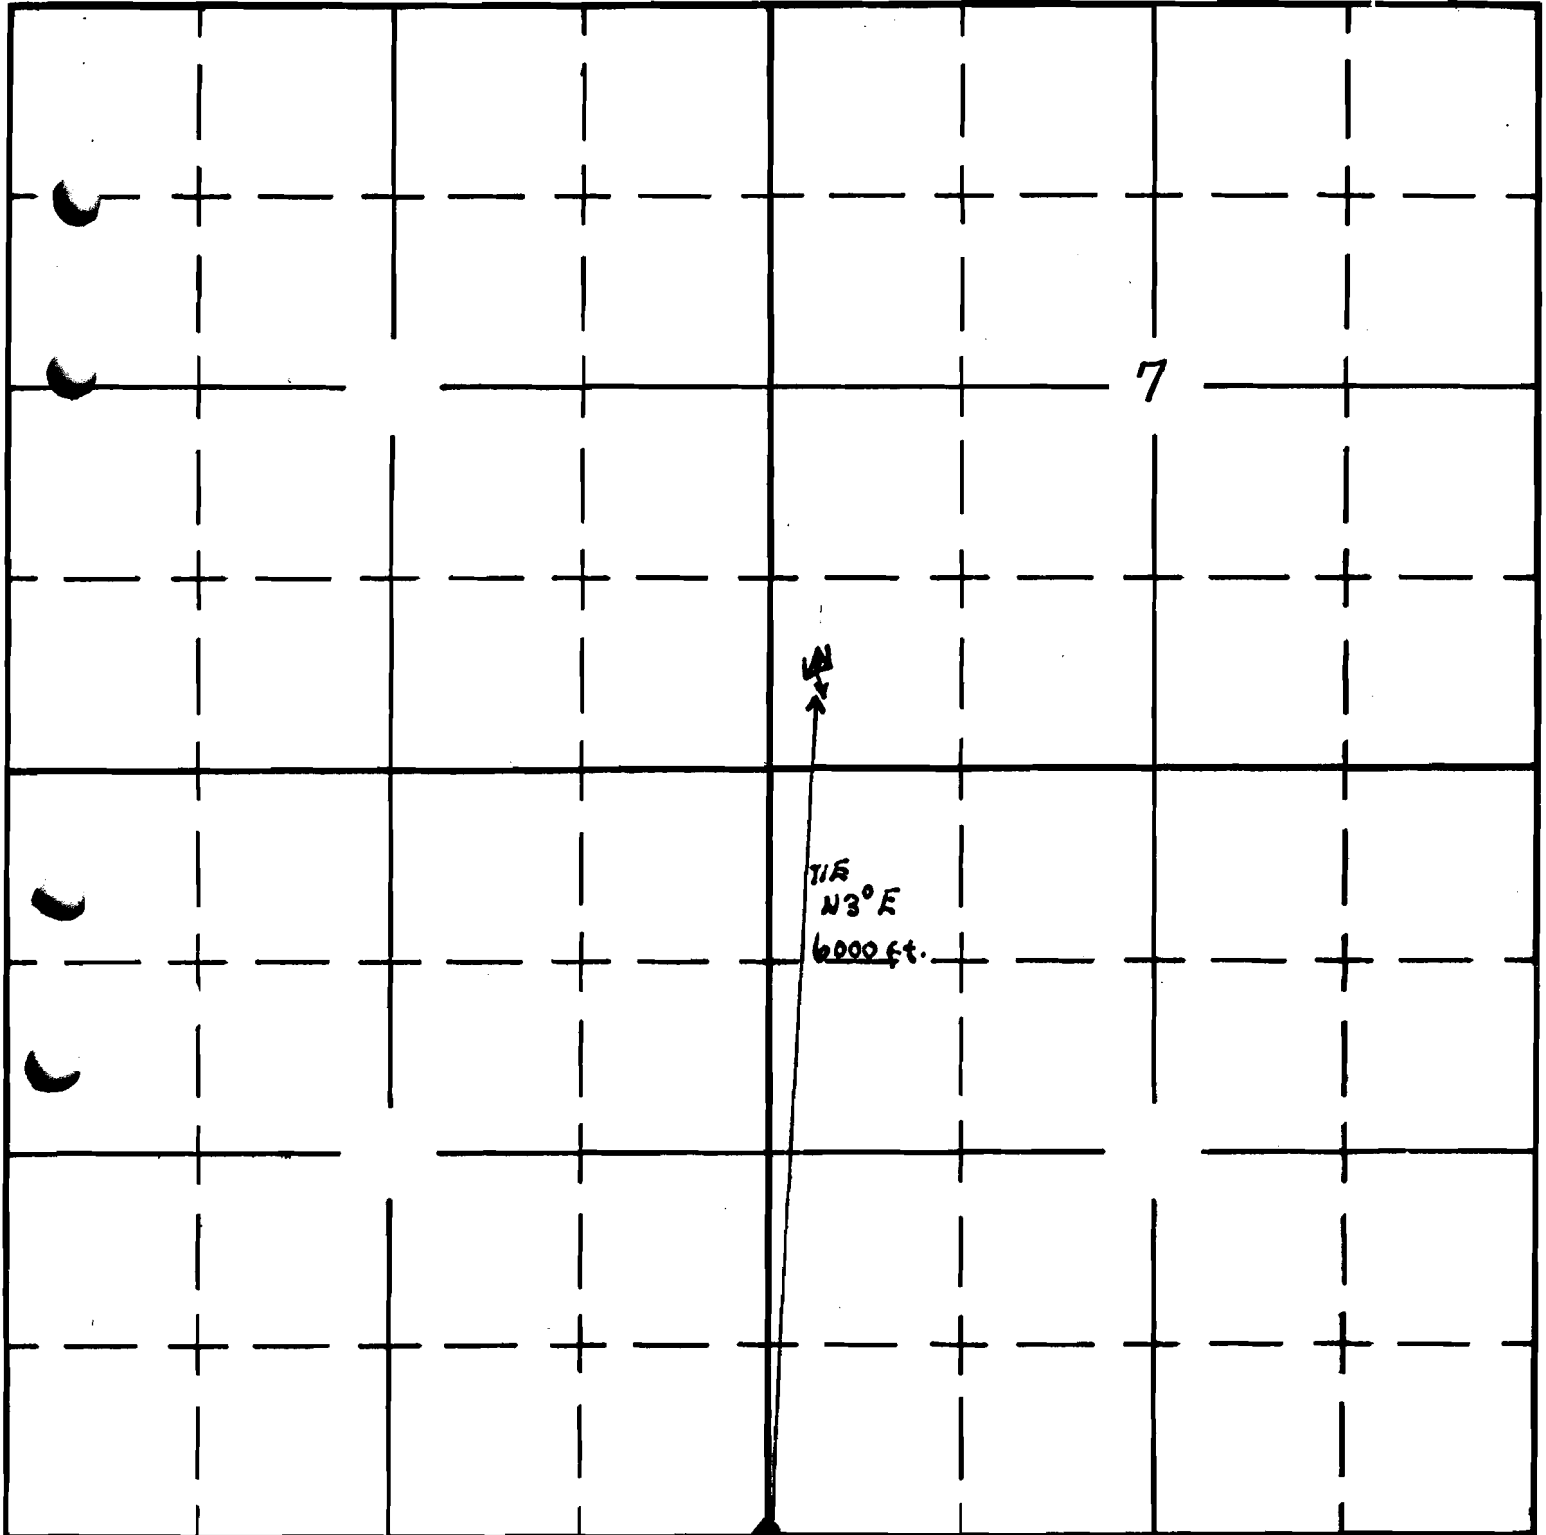

◆ FOUND SURVEY CORNER
W PROJECT

Application No. R-34234 APPLICATION No.
Permit No. R-2486 PERMIT No.