

UNITED STATES
DEPARTMENT OF THE INTERIOR
BUREAU OF LAND MANAGEMENT

R-2543
75377


SECTION _____

Oregon State Water Filings

TOWNSHIP 28S, RANGE 15E, W. M.

RECEIVED
JAN 1981
BUREAU OF LAND MANAGEMENT

North DUDLEY WATERHOLE RECONSTRUCTION

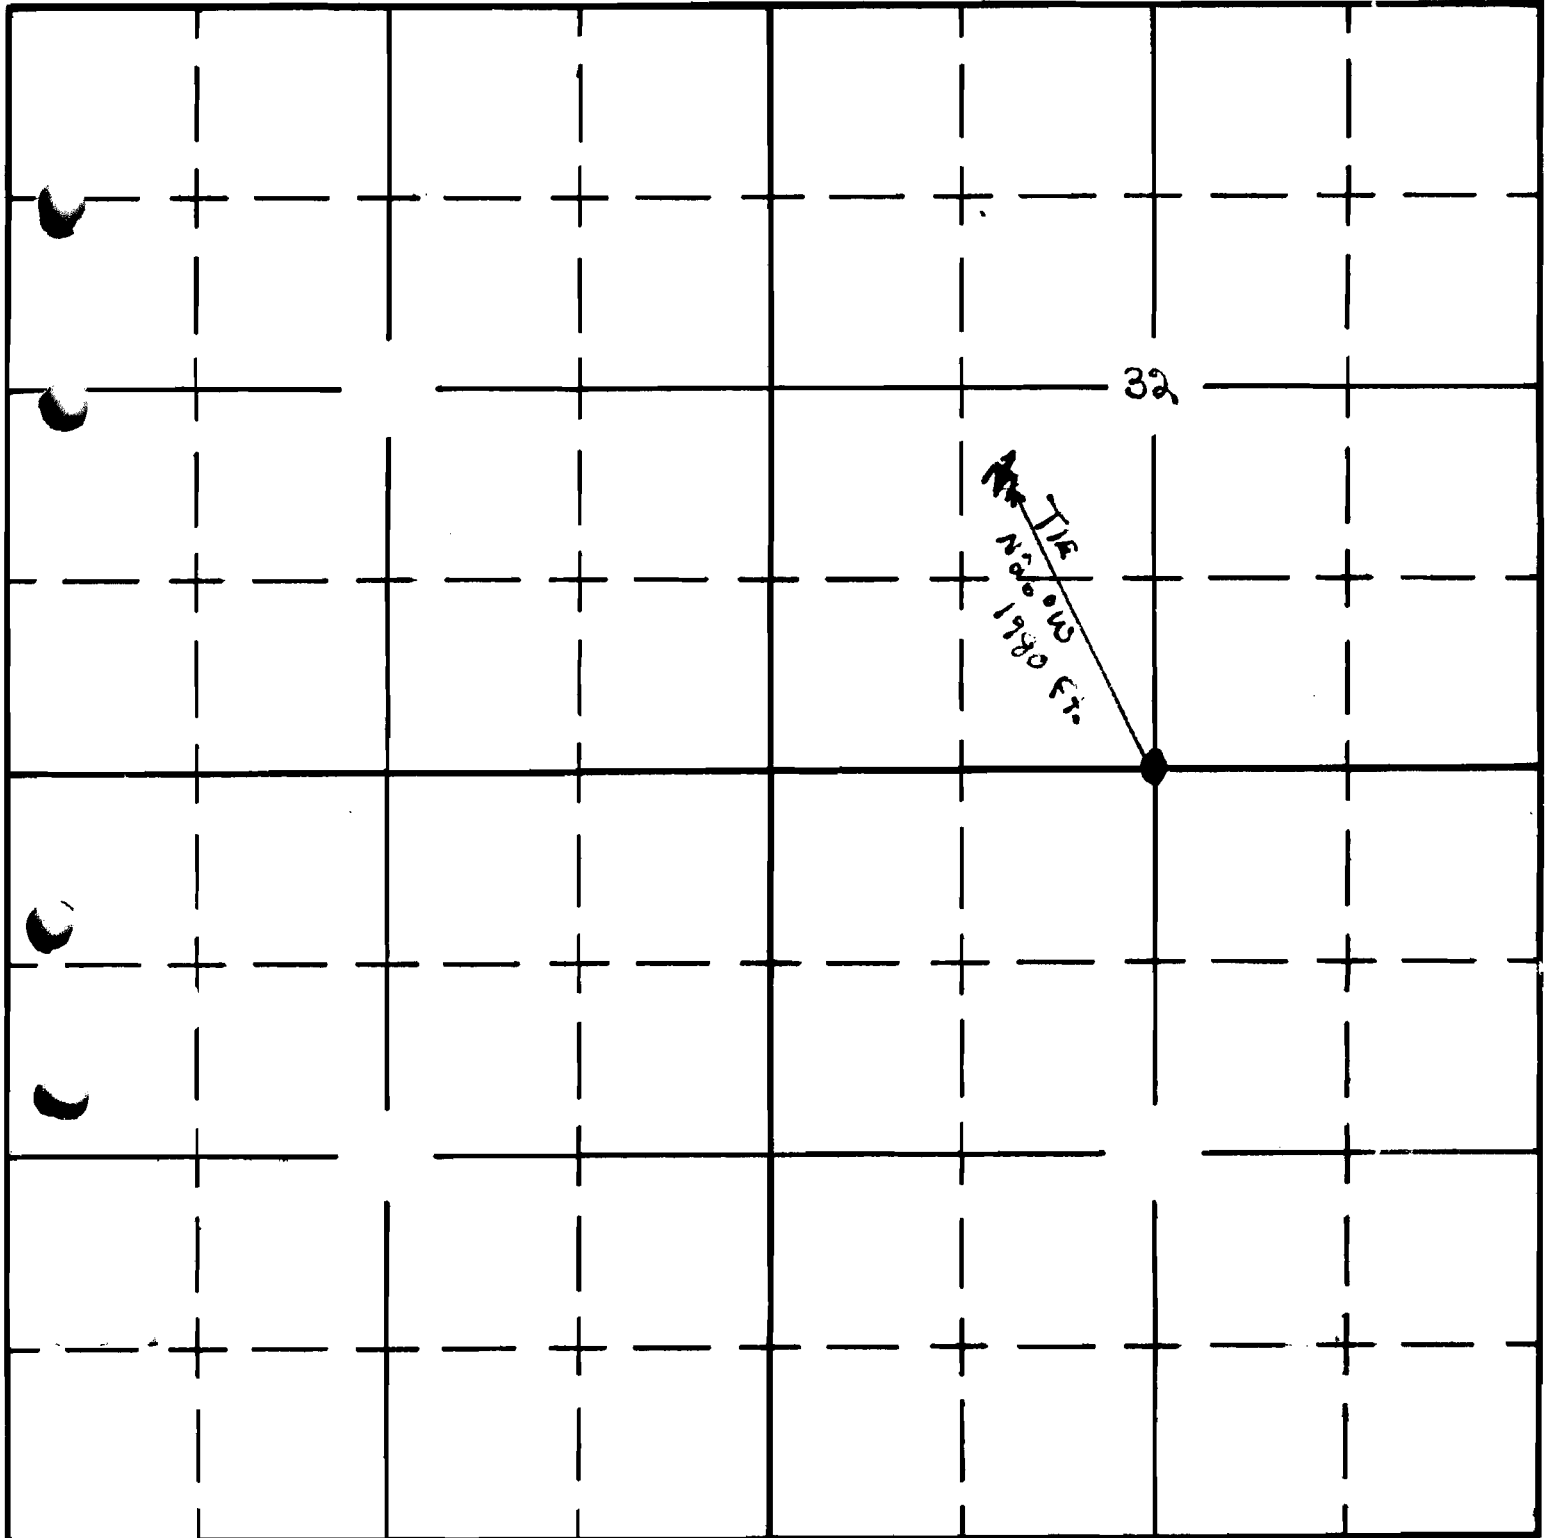

◆ FOUND SURVEY CORNER

South

W PROJECT

APPLICATION No. R-3436
PERMIT No. R-2543