

Form AI-187
March 1961

UNITED STATES
DEPARTMENT OF THE INTERIOR
BUREAU OF LAND MANAGEMENT


SECTION

30

NE 1/4 NE 1/4

Oregon State Water Filings

TOWNSHIP 35S, RANGE 20E, W. M.

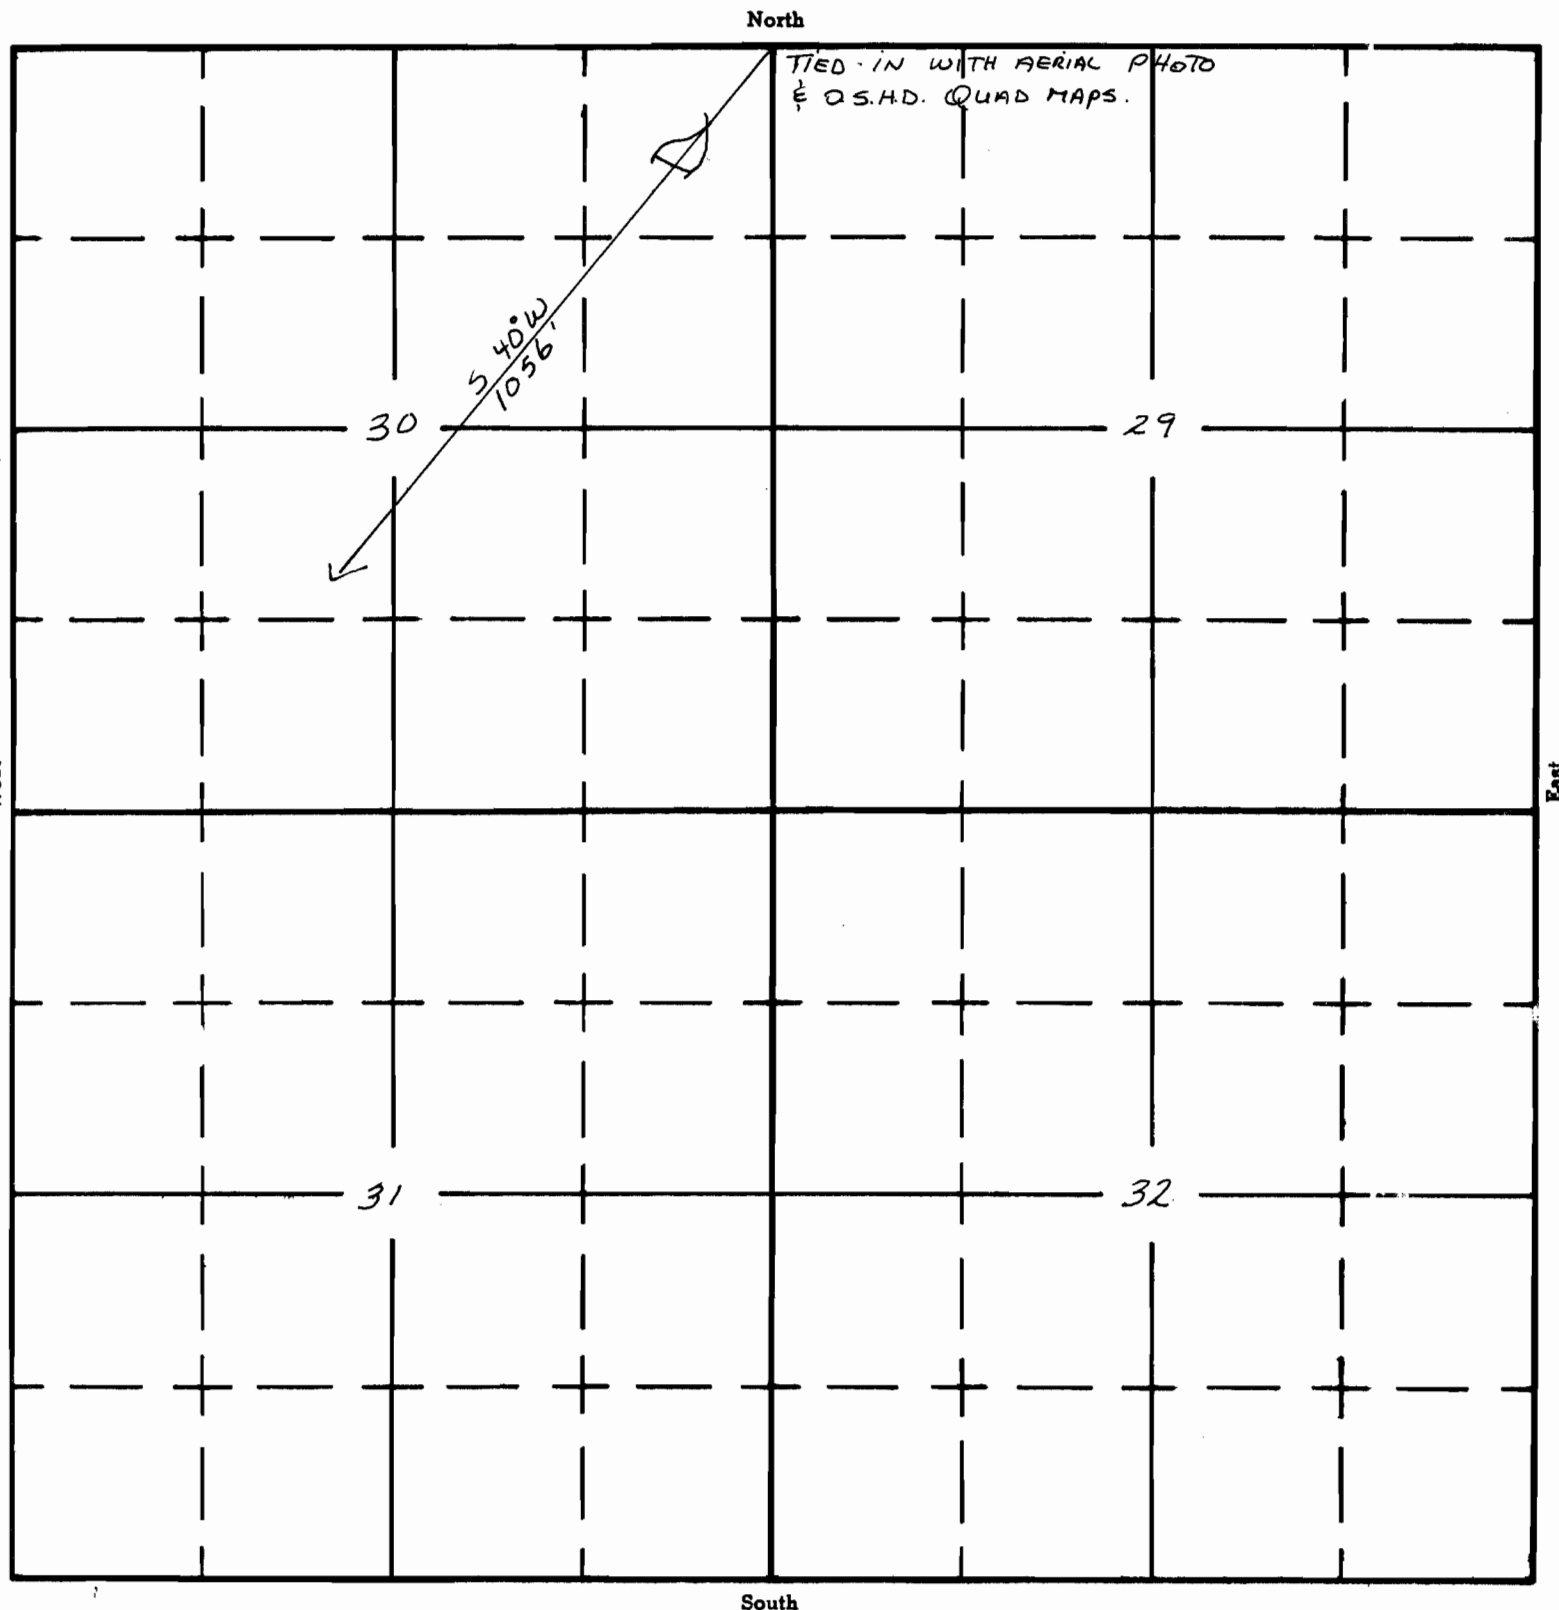

APPLICATION No. R-35128
PERMIT No. R-2835