

UNITED STATES
DEPARTMENT OF THE INTERIOR
BUREAU OF LAND MANAGEMENT


RECEIVED
MAR 13 1961
STATE ENGINEER
SALES OFFICE

SECTION

28

Oregon State Water Filings

TOWNSHIP 37S, RANGE 23E, W. M.

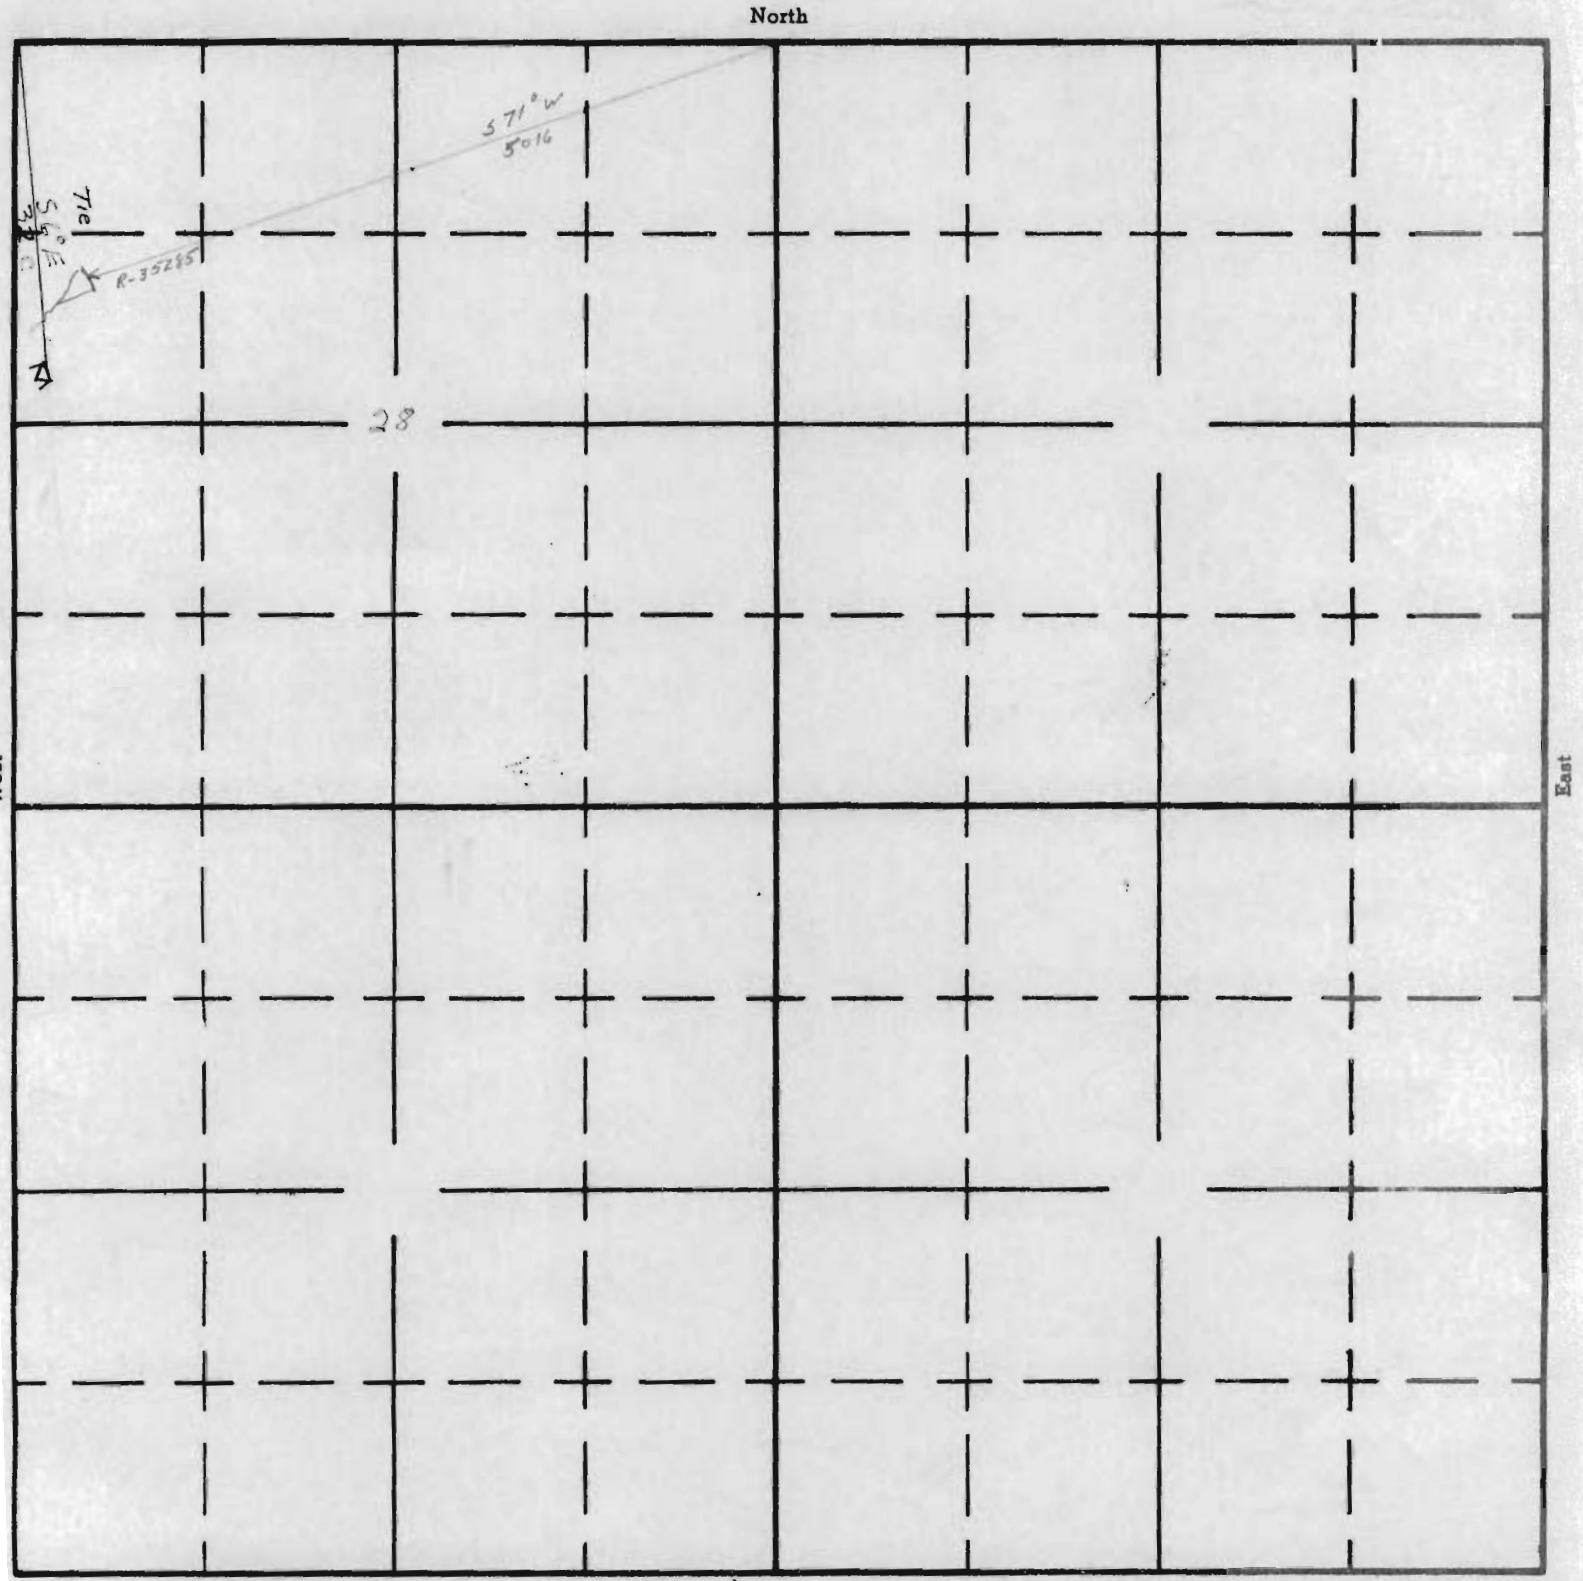

No CORNER Found
Tied in with Aerial Photos and Oregon State Highway Ground maps

APPLICATION No. R-34711
PERMIT No. R-2810