

UNITED STATES
DEPARTMENT OF THE INTERIOR
BUREAU OF LAND MANAGEMENT


R-2828
75383

SECTION

24

Oregon State Water Filings

TOWNSHIP 29-S RANGE 15-E W. M.

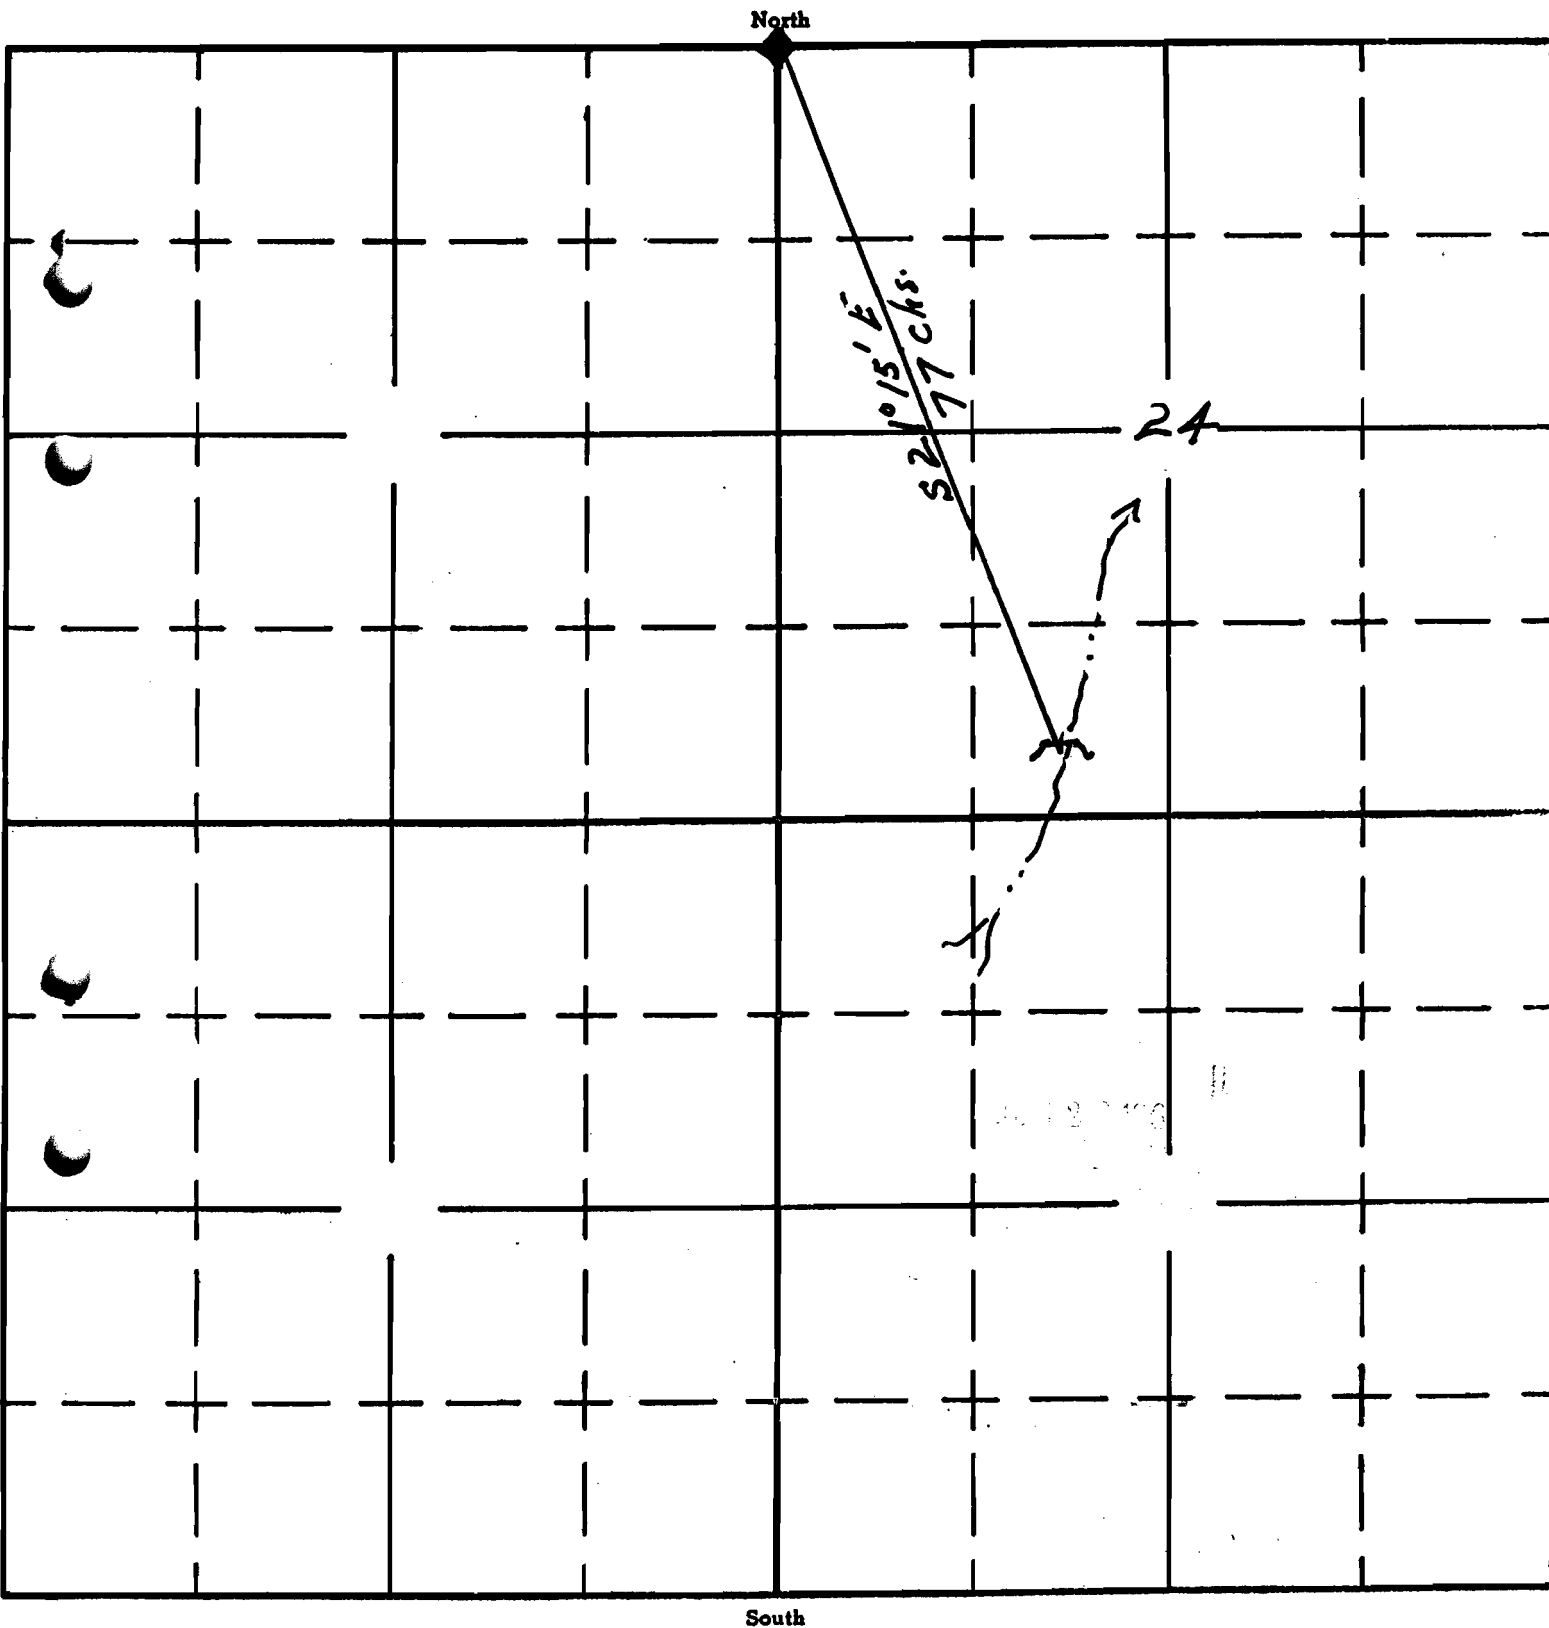

APPLICATION No. R-3508
PERMIT No. R-2828