

UNITED STATES
DEPARTMENT OF THE INTERIOR
BUREAU OF LAND MANAGEMENT

SECTION


10

NW¹4 SE¹4

Oregon State Water Filings

TOWNSHIP 28S, RANGE 18E, W. M.

North

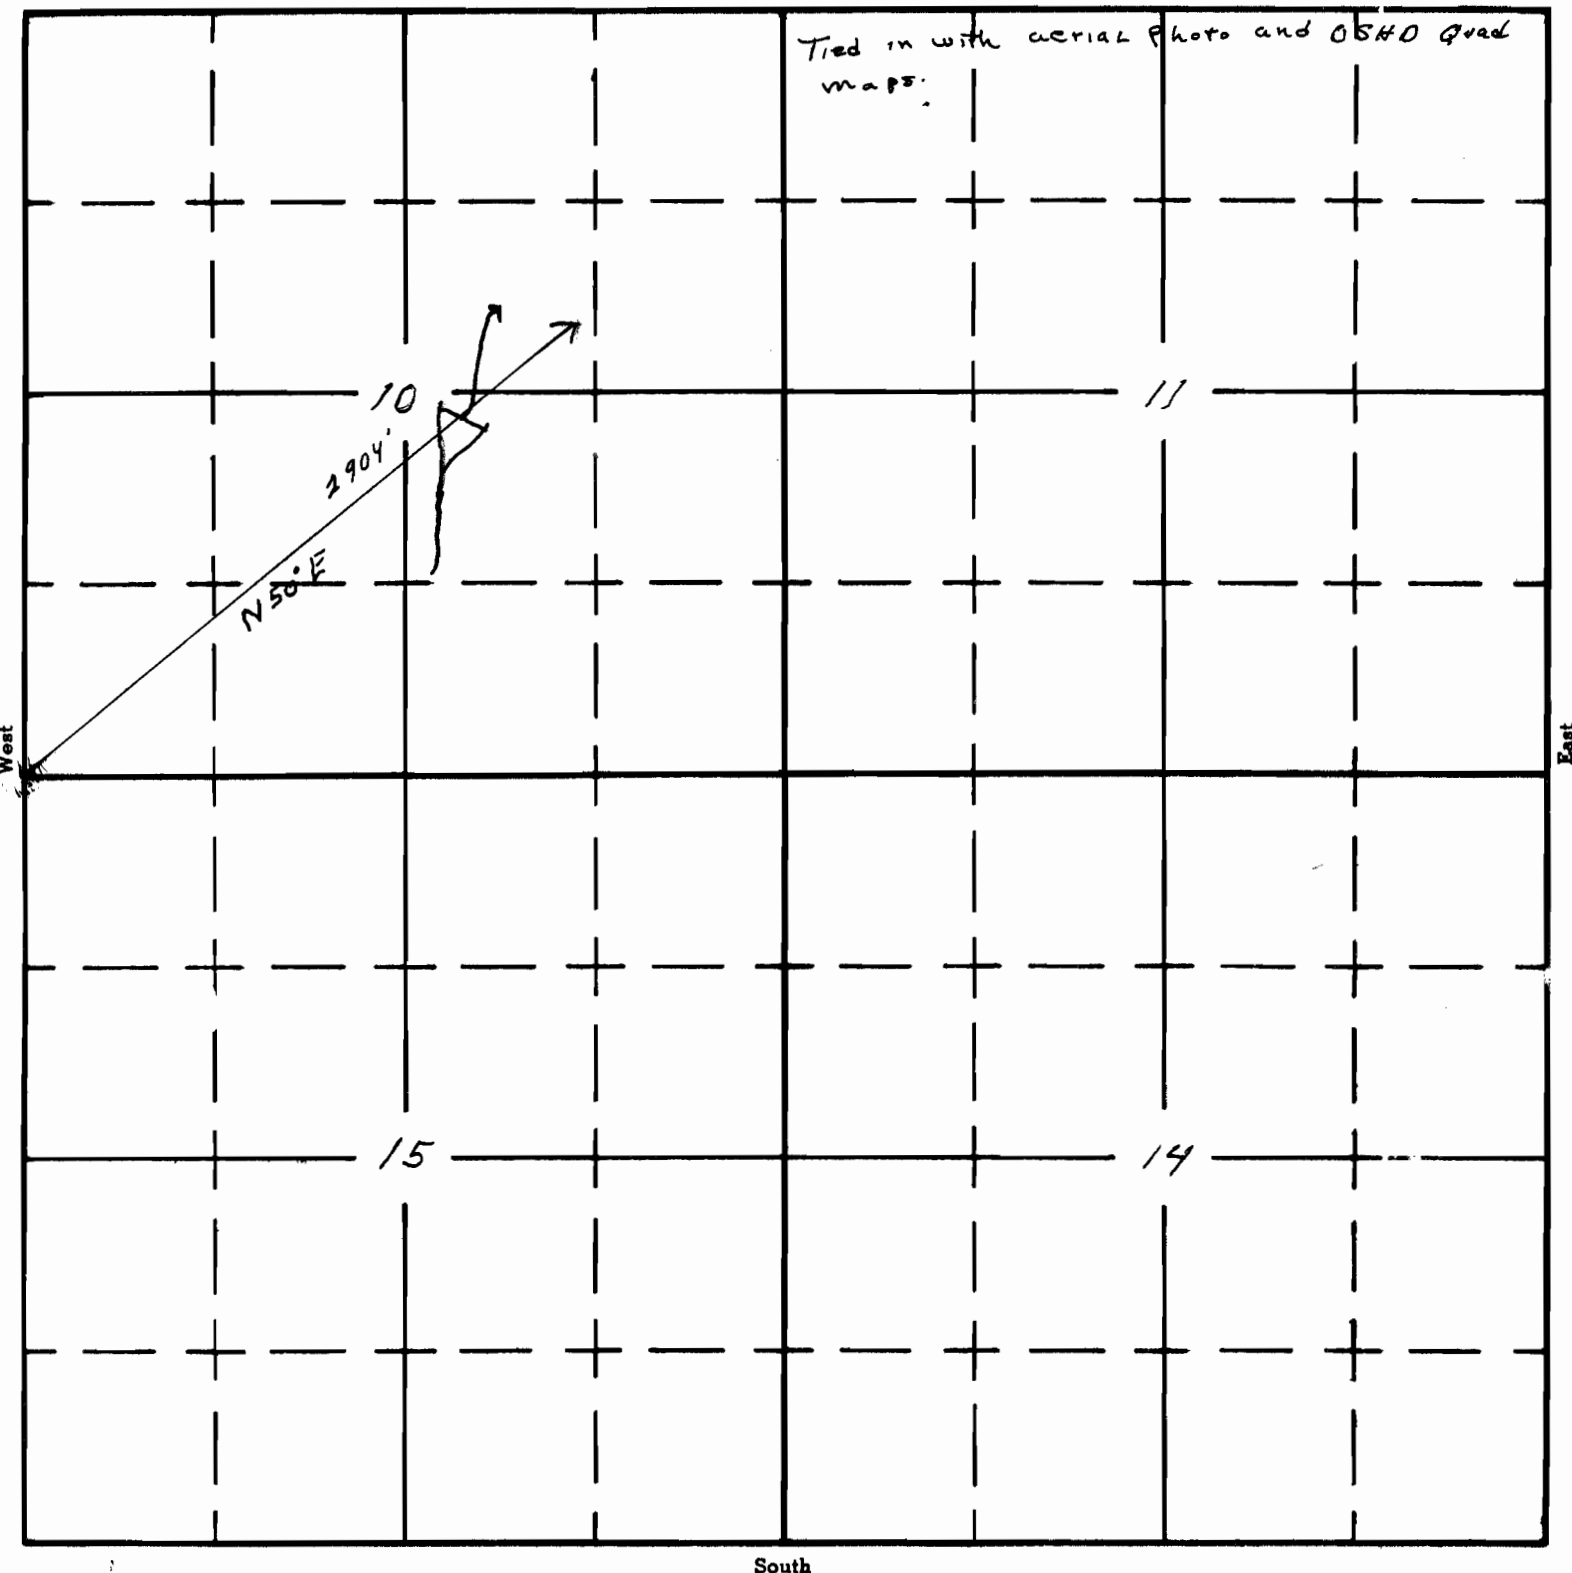

APPLICATION No. R-35257
PERMIT No. R-3021