

UNITED STATES
DEPARTMENT OF THE INTERIOR
BUREAU OF LAND MANAGEMENT

R-6877
75387

SECTION


8

Oregon State Water Filings

SE¹/₄ SE¹/₄

TOWNSHIP 24S, RANGE 19E, W. M.

North

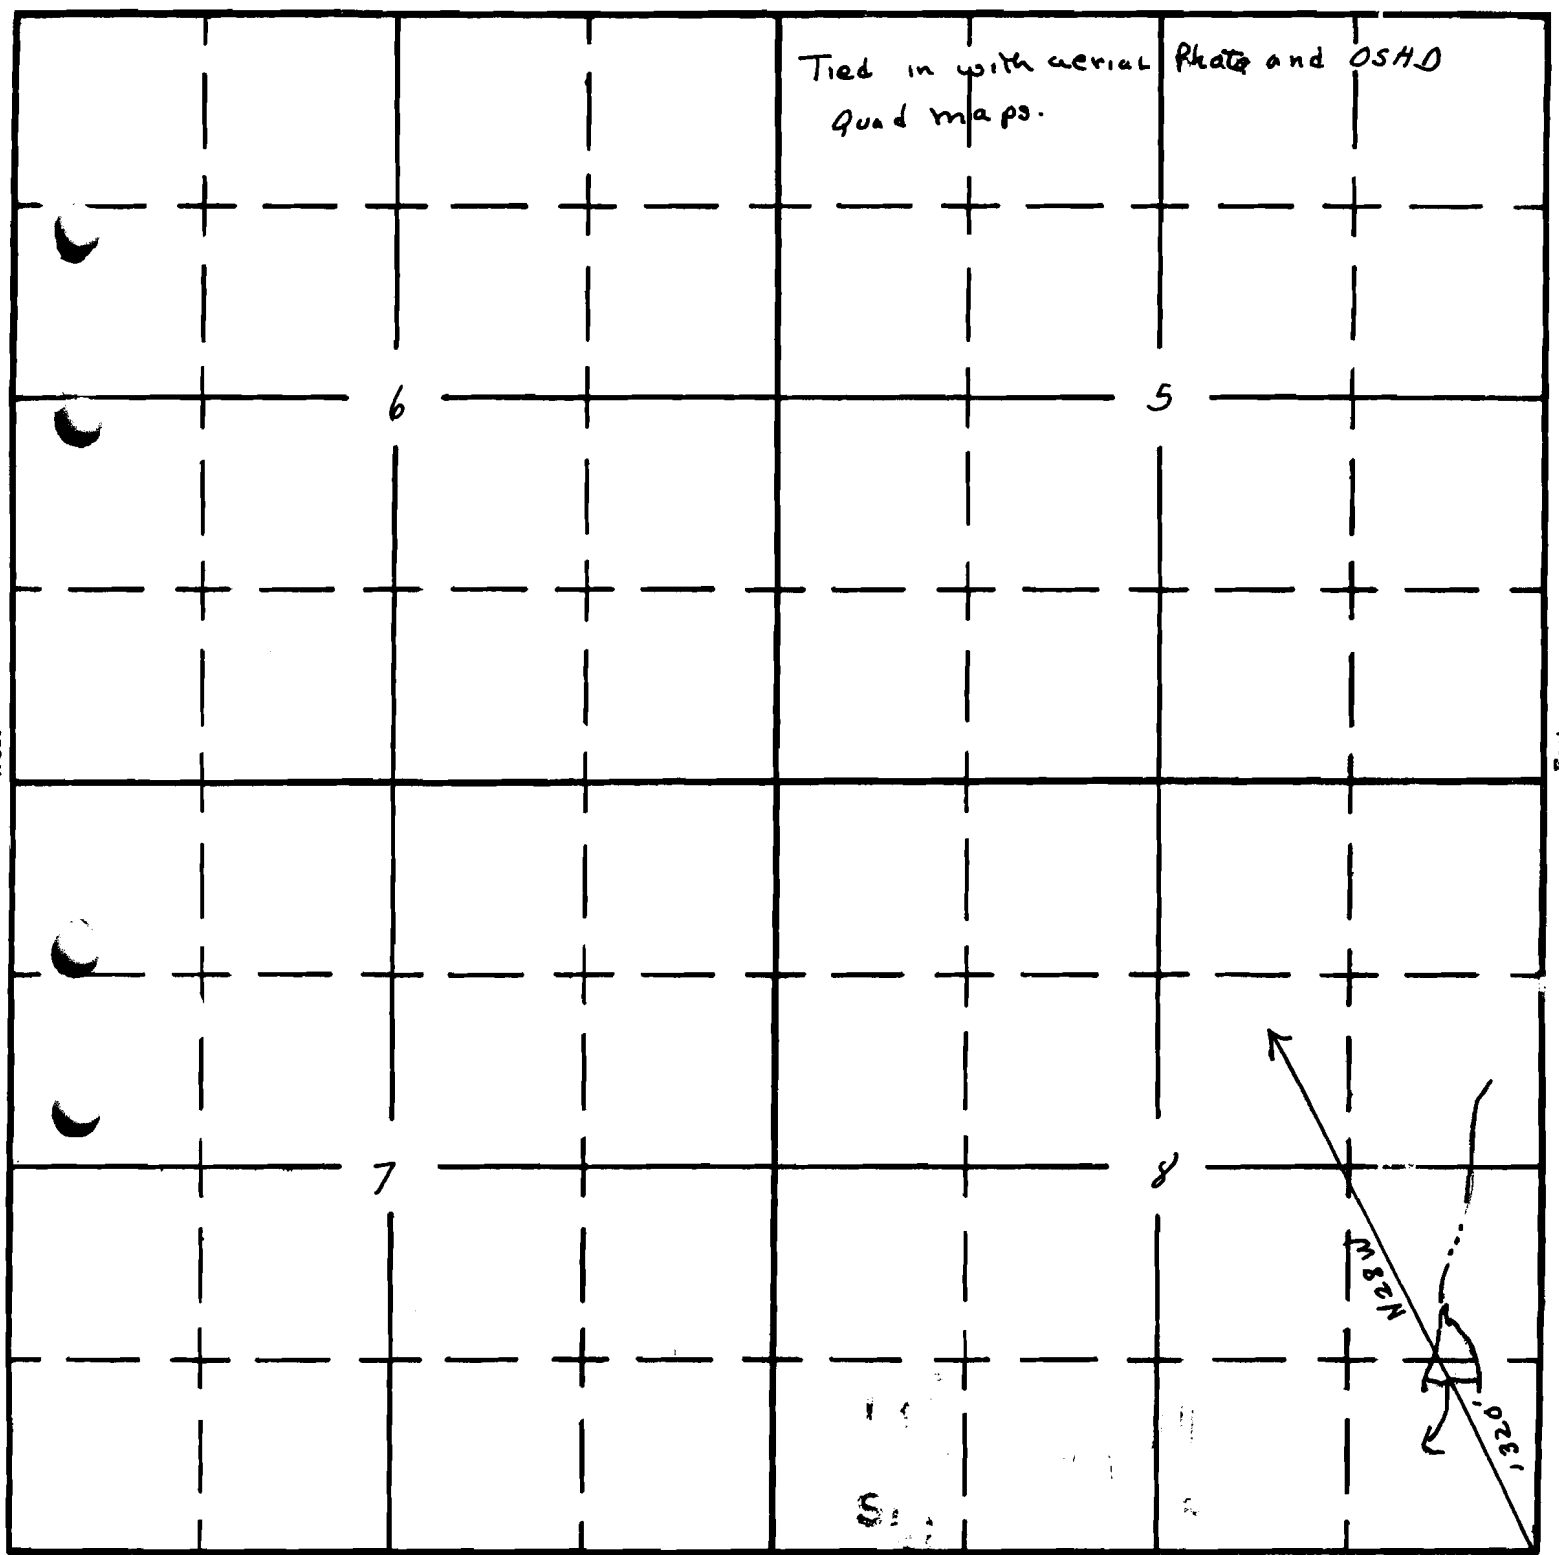

South