

Form AI-187
March 1961


UNITED STATES
DEPARTMENT OF THE INTERIOR
BUREAU OF LAND MANAGEMENT

R6962
75388

SECTION
10
NE 1/4 NW 1/4

Oregon State Water Filings

TOWNSHIP 39S, RANGE 26E, W. M.

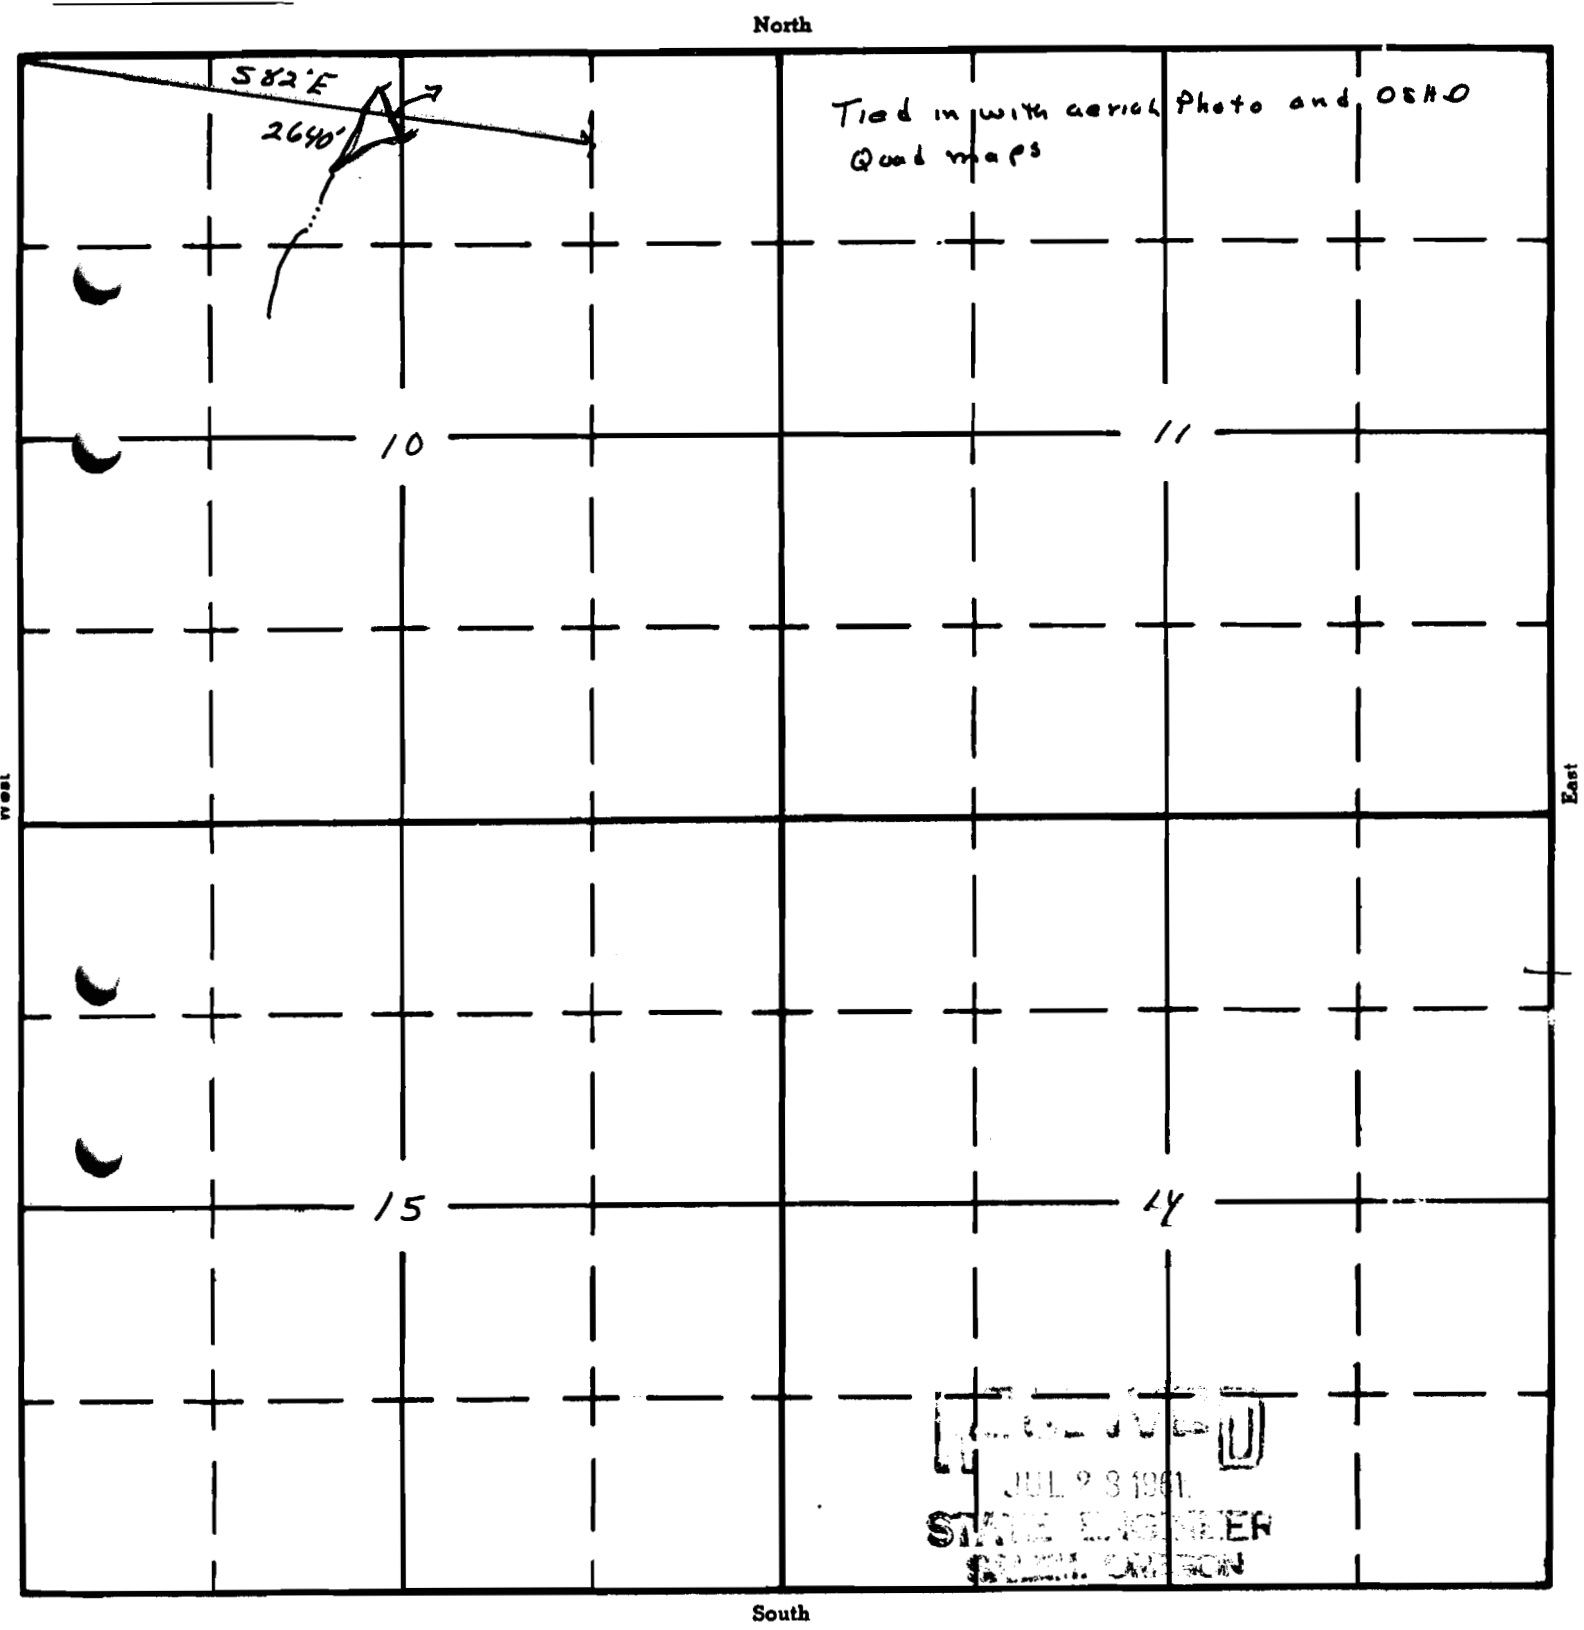

APPLICATION No. R-35807
PERMIT No. **6963**