


Oregon State Water Filings

TOWNSHIP 29S, RANGE 24E, W. M.

Tied-in with aerial photo ^{20th} i D.S.H.D. Quad Nass

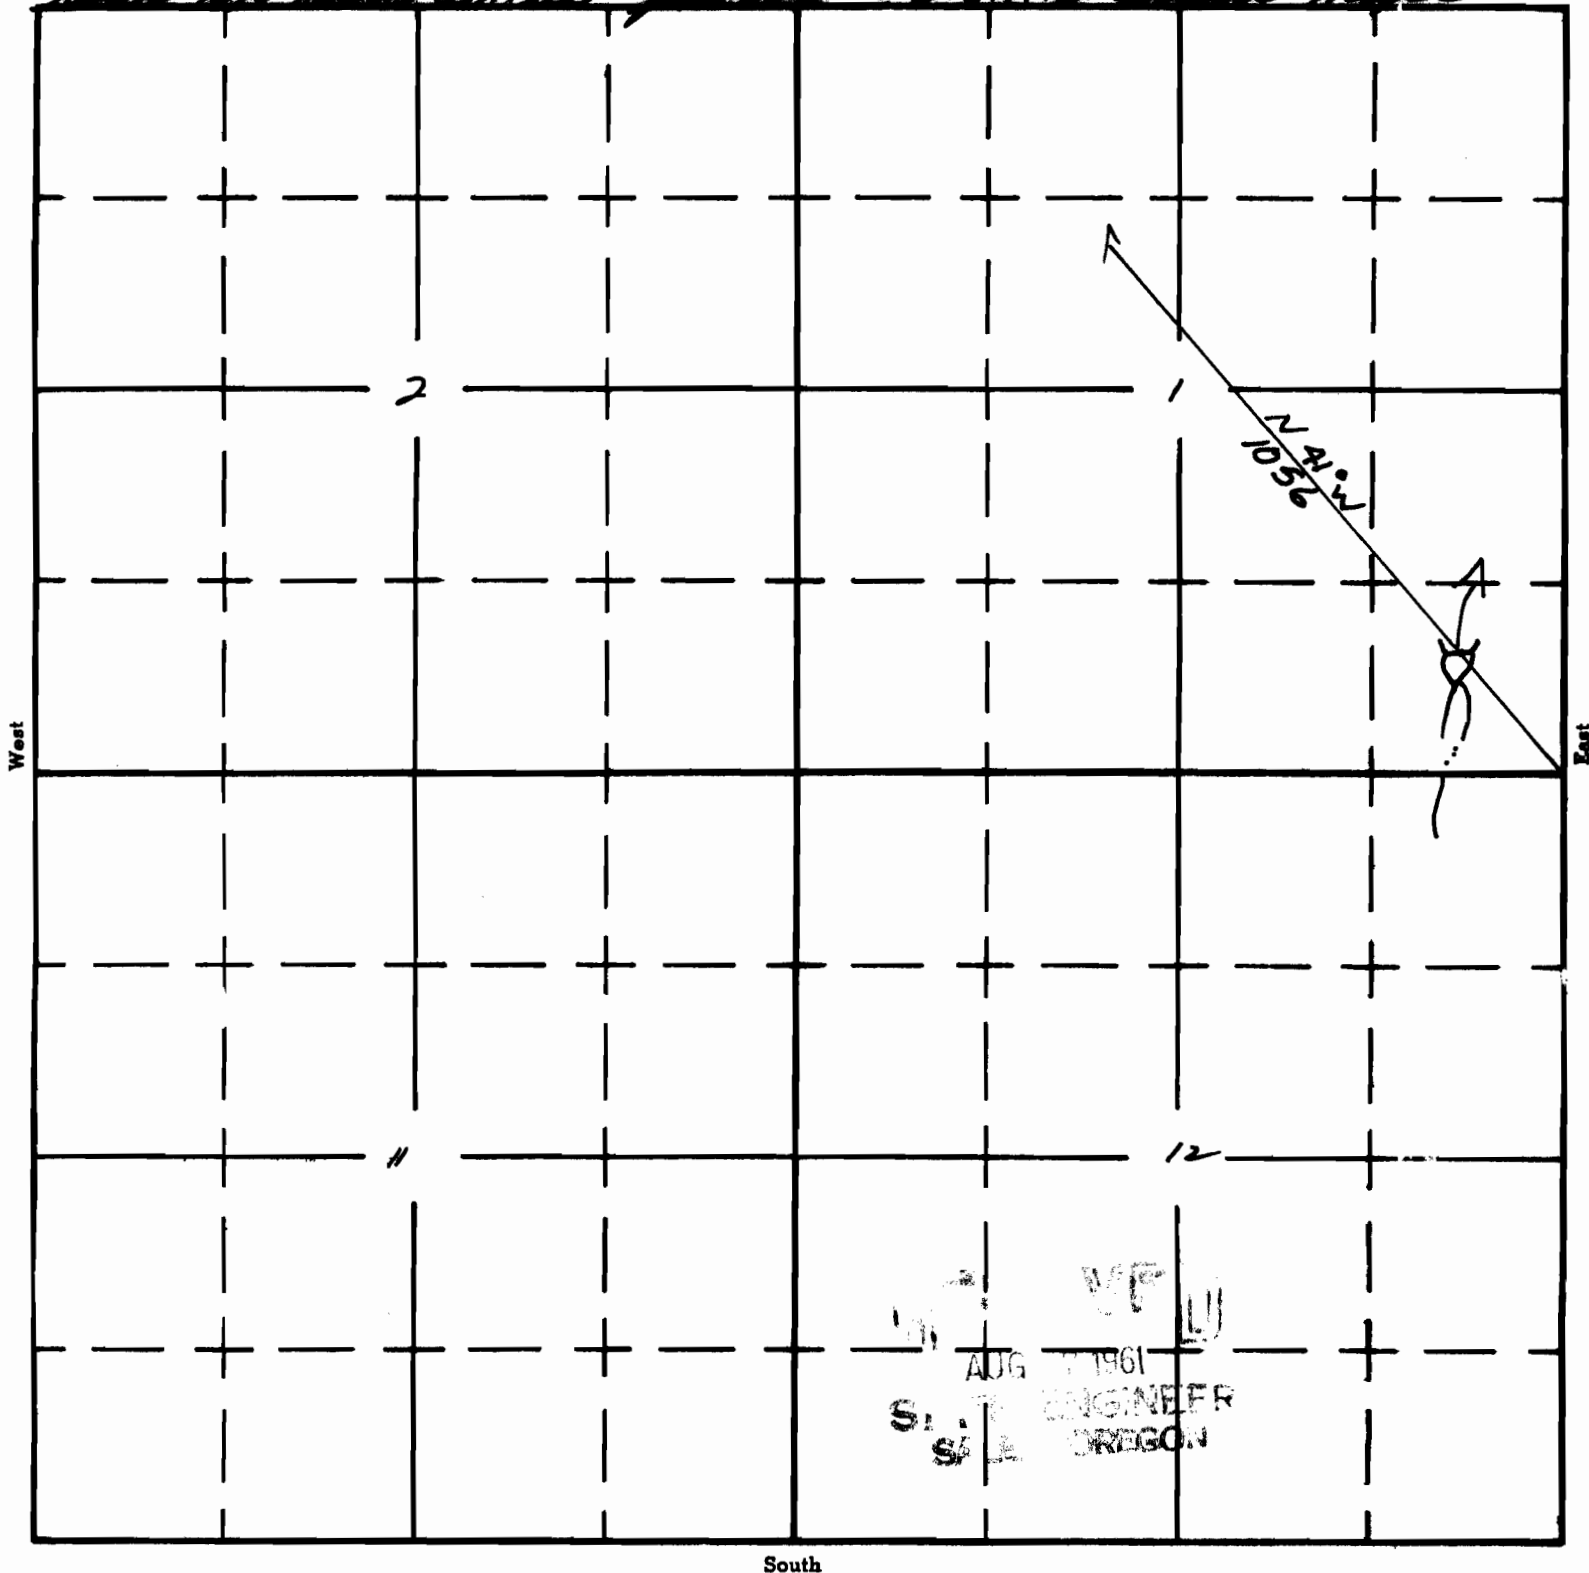

APPLICATION No *R-36164*
PERMIT No *R-3570*