

UNITED STATES
DEPARTMENT OF THE INTERIOR
BUREAU OF LAND MANAGEMENT

SECTION


4

NE 1/4 SW 1/4

Oregon State Water Filings

TOWNSHIP 39S, RANGE 29E, W. M.

North *Tied in with aerial Photo and 2500 Quad Maps*

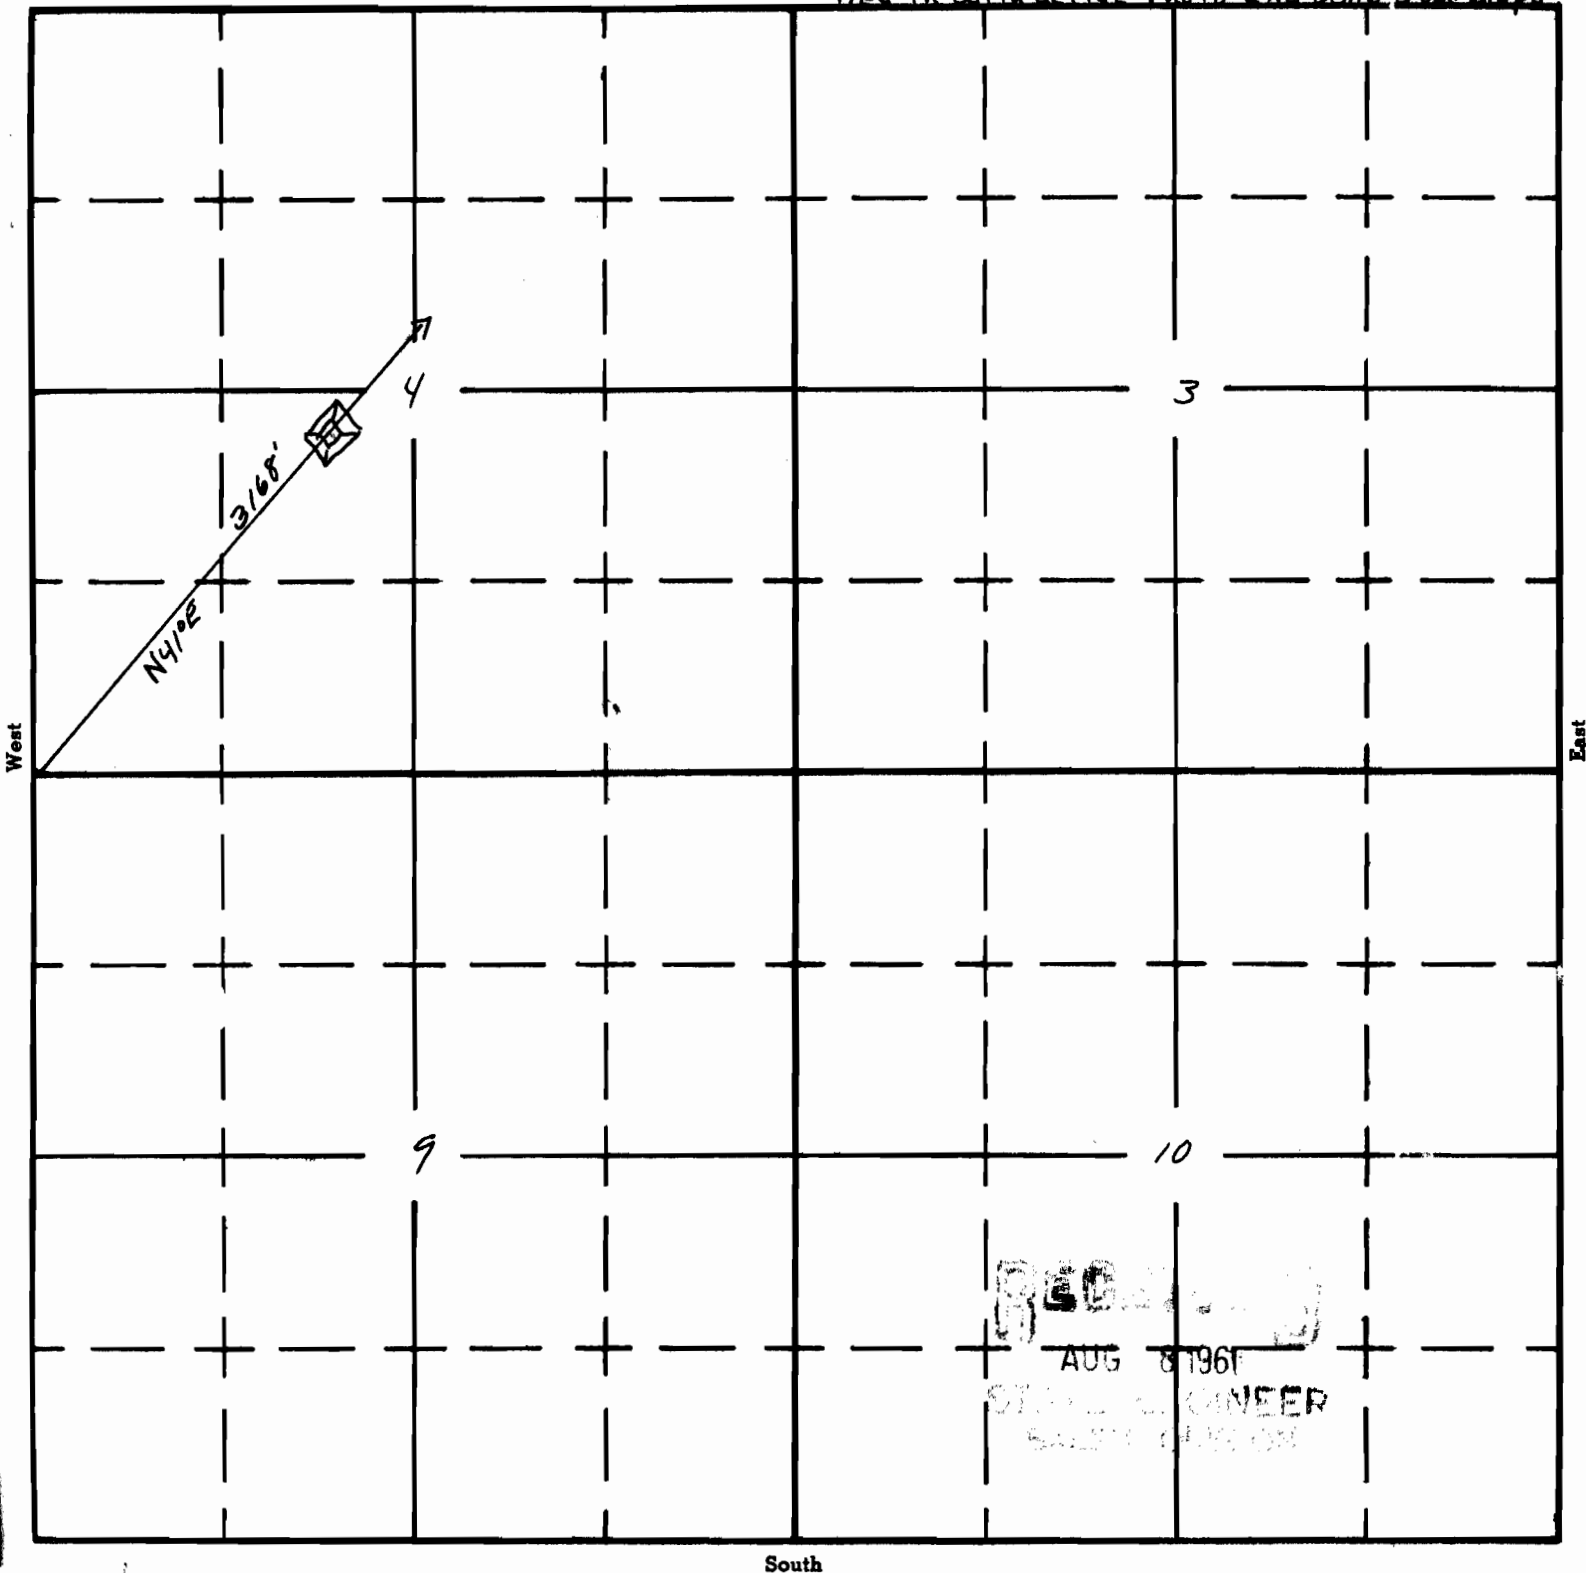

APPLICATION No. R-36540
PERMIT No. R-4248